

STATE ENGINEER
Salem, Oregon

MAR 2558 Well Record

STATE WELL NO. 5/2W-20D(1)
COUNTY Marion
APPLICATION NO.

OWNER: Norman Neibler


MAILING ADDRESS:

LOCATION OF WELL: Owner's No.

CITY AND STATE:

1/4 1/4 Sec. T. N. E. S., R. W., W.M.

Bearing and distance from section or subdivision corner

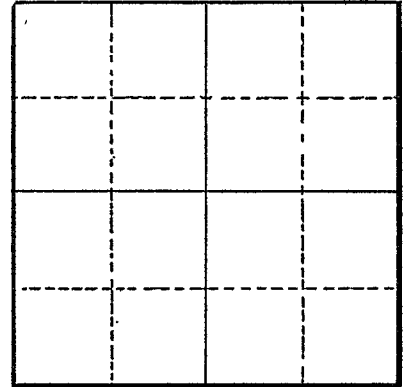

Section

Altitude at well 169

TYPE OF WELL: Drilled Date Constructed 1955

Depth drilled 116 Depth cased 116

CASING RECORD:

12 inch

FINISH:

Casing perforated 92 to 115

AQUIFERS:

Sand and gravel from 68 to 70
Sand and gravel from 92 to 116

WATER LEVEL:

12 feet below land surface on April 9, 1955

PUMPING EQUIPMENT: Type Turbine H.P. 10
Capacity G.P.M.

WELL TESTS:

Drawdown ft. after hours G.P.M.
Drawdown ft. after hours G.P.M.

USE OF WATER Irrigation--60 acres Temp. °F., 19

SOURCE OF INFORMATION USGS

DRILLER or DIGGER

ADDITIONAL DATA:

Log Water Level Measurements Chemical Analysis Aquifer Test

REMARKS: