

STATE ENGINEER
Salem, Oregon

MARI... 2559

Well Record

STATE WELL NO. 5/2W-20E
COUNTY Marion
APPLICATION NO. GR-1259

GR- 1215

OWNER: Norman & Florence Nibler


MAILING ADDRESS: Rt. 1, Box 430

LOCATION OF WELL: Owner's No.

CITY AND STATE: Woodburn, Oregon

SW 1/4 NW 1/4 Sec. 20 T. 5 S., R. 2 W., W.M.

Bearing and distance from section or subdivision corner 1400' S. & 710' E. from NW cor. Sec. 20.

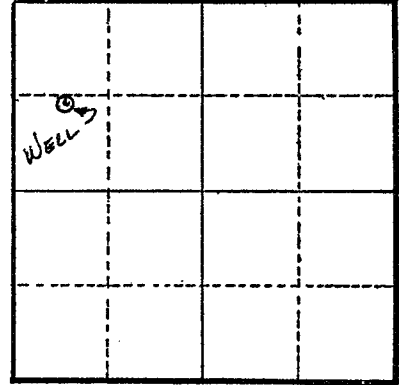

Section 20

Altitude at well 210 ft.

TYPE OF WELL: Drilled Date Constructed 1955

Depth drilled 116 ft. Depth cased 116 ft.

CASING RECORD:

12 inch

FINISH:

180 mill knife perforations from 92 to 115 ft.

AQUIFERS:

WATER LEVEL:

12 ft.

PUMPING EQUIPMENT: Type Jacuzzi turbine

H.P. 10

Capacity 175 G.P.M.

WELL TESTS:

Drawdown 25 ft. after 300 hours G.P.M.

Drawdown 47 ft. after 475 hours G.P.M.

USE OF WATER Irrigation Temp. °F. 19

SOURCE OF INFORMATION G. R. Record

DRILLER or DIGGER

ADDITIONAL DATA:

Log Water Level Measurements Chemical Analysis Aquifer Test

REMARKS: Irrigation of 60 acres.

Log: Surface soil	0 to 3 ft.
Clay	3 to 23 ft.
Surface sand	23 to 27 ft.
Gray clay	27 to 68 ft.
Sand & small gravel (water)	68 to 70 ft.
Clay	70 to 91 ft.
Sand	91 to 92 ft.
Sand & gravel	92 to 115 ft.
Sand & large gravel	115 to 116 ft.