

STATE ENGINEER  
Salem, Oregon

2598  
MARI

# Well Record

STATE WELL NO. 5/2W-21K  
COUNTY Marion  
APPLICATION NO. GR-4214

OWNER: Delbert C. Shellito


MAILING ADDRESS: Route 1, Box 240

LOCATION OF WELL: Owner's No.

CITY AND STATE: Gervais, Oregon

NW 1/4 SE 1/4 Sec. 21 T. 5 S., R. 2 W., W.M.

Bearing and distance from section or subdivision corner 7.8 chs. S. & 63 chs. W. from most E. NE Cor. DLC 51

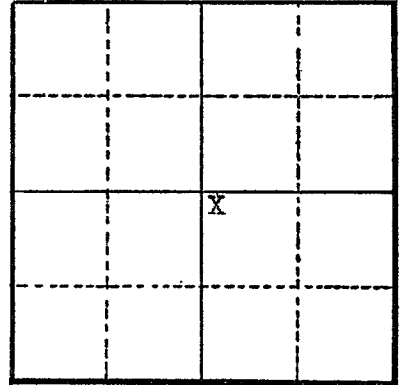

Section 21

Altitude at well

TYPE OF WELL: Drilled Date Constructed 1950

Depth drilled 112 ft. Depth cased 112 ft.

### CASING RECORD:

6 inch casing set to 112 feet

### FINISH:

### AQUIFERS:

### WATER LEVEL:

25 feet below surface

PUMPING EQUIPMENT: Type Turbine H.P. 5  
Capacity 100 G.P.M.

### WELL TESTS:

Drawdown ft. after hours G.P.M.  
Drawdown ft. after hours G.P.M.

USE OF WATER Irrigation Temp. °F. 19

SOURCE OF INFORMATION Well Registration Statement Cert. # GR-3759

DRILLER or DIGGER

### ADDITIONAL DATA:

Log Water Level Measurements Chemical Analysis Aquifer Test

### REMARKS: