

MARI 2599


# Well Record

OWNER: Delber C. Shellito MAILING ADDRESS:

LOCATION OF WELL: Owner's No. CITY AND STATE:

..... 1/4 ..... 1/4 Sec. ..... T. N. E. S., R. W., W.M.

Bearing and distance from section or subdivision corner

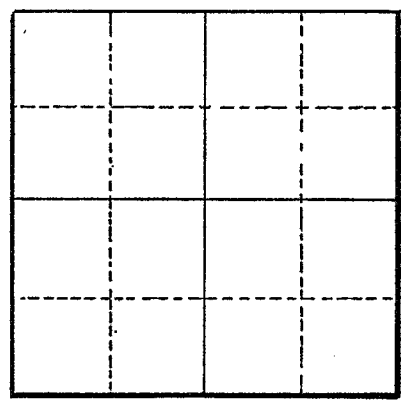

Section

Altitude at well 181

TYPE OF WELL: Drilled Date Constructed 1950

Depth drilled 112 Depth cased

### CASING RECORD:

6 inch

### FINISH:

### AQUIFERS:

### WATER LEVEL:

PUMPING EQUIPMENT: Type Turbine H.P. 5  
Capacity G.P.M.

### WELL TESTS:

Drawdown ft. after hours G.P.M.  
Drawdown ft. after hours G.P.M.

USE OF WATER Domestic, Irrigation-15 Temp. °F., 19  
SOURCE OF INFORMATION USGS. acres.

DRILLER or DIGGER

### ADDITIONAL DATA:

Log Water Level Measurements Chemical Analysis Aquifer Test

### REMARKS: