

STATE ENGINEER
Salem, Oregon

MARI... 2600

Well Record

GR- 1726

STATE WELL NO. 5/2W-21L
COUNTY Marion
APPLICATION NO. GR- 1784

OWNER: Lloyd L. Ferschweiler


MAILING ADDRESS: Rt. 1, Box 249

LOCATION OF WELL: Owner's No.

CITY AND STATE: Gervais, Oregon

NE 1/4 SW 1/4 Sec. 21 T. 5 S, R. 2 W., W.M.

Bearing and distance from section or subdivision corner 1600' N. & 3100' E. from SW cor. BLC #42

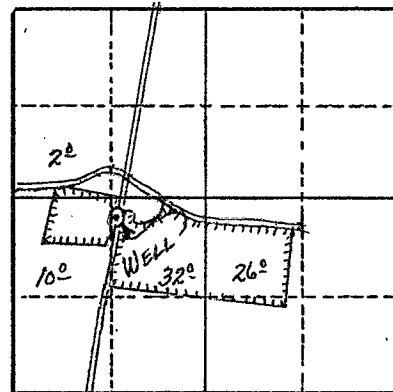

Section 21

Altitude at well 180'

TYPE OF WELL: Drilled Date Constructed 1951

Depth drilled 134' Depth cased 131'

CASING RECORD:

? 7" O.D.

6"

FINISH:

AQUIFERS:

WATER LEVEL:

12' (12-11-51)

PUMPING EQUIPMENT: Type Peerless turbine H.P. 10
Capacity 175 G.P.M.

WELL TESTS:

Drawdown 33 ft. after 12-1-51 hours 160 G.P.M.

Drawdown 41 ft. after hours 175 G.P.M.

USE OF WATER Irrigation Temp. °F., 19

SOURCE OF INFORMATION GR Record

DRILLER or DIGGER

ADDITIONAL DATA:

Log N.A. Water Level Measurements Chemical Analysis Aquifer Test

REMARKS:

Irrigation of 70 acres.