

STATE ENGINEER
Salem, Oregon

2648
MARI....

Well Record

STATE WELL NO. 5/2W-24D
COUNTY Marion
APPLICATION NO. GR-909

OWNER: John A. Moron


MAILING ADDRESS: 925 Dearborn Avenue

LOCATION OF WELL: Owner's No. 1

CITY AND STATE: Salem, Oregon

NW 1/4 NW 1/4 Sec. 24 T. 5 S., R. 2 W., W.M.

Bearing and distance from section or subdivision corner 1160' S. & 200' E. from NE cor. Sec. 23

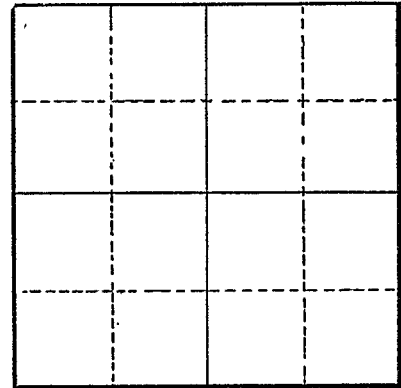

Section

Altitude at well 180

TYPE OF WELL: Drilled Date Constructed Feb. '53

Depth drilled 136 Depth cased 136

CASING RECORD:

8" diameter black, welded 0 to 136 feet

FINISH:

Perforations: Mills perforator 78 cuts 124-135 feet

AQUIFERS:

Water bearing sand and gravel 123 to 136 feet

WATER LEVEL:

15 feet (2-24-53)

PUMPING EQUIPMENT: Type Fairbanks Morse direct turbine H.P. 27
Capacity G.P.M. w/Watson Flexible drive Olive diesel

WELL TESTS:

Drawdown 30 ft. after 210 hours G.P.M.
Drawdown 44 ft. after 310 hours G.P.M.

USE OF WATER Irrigation 78 acres Temp. °F., 19

SOURCE OF INFORMATION owner

DRILLER or DIGGER

ADDITIONAL DATA:

Log Water Level Measurements Chemical Analysis Aquifer Test

REMARKS:

