

STATE ENGINEER  
Salem, Oregon

265//  
MAR1....

# Well Record

STATE WELL NO. 5/2W-24Q  
COUNTY Marion  
APPLICATION NO. GR-3887

OWNER: Wilford Nelson


MAILING ADDRESS:

LOCATION OF WELL: Owner's No.

CITY AND STATE: Hubbard, Oregon

SW 1/4 SE 1/4 Sec. 24 T. 5 N. S, R. 2 E W., W.M.

Bearing and distance from section or subdivision corner 1525' W. & 1100' N. from SE cor. Sec. 24

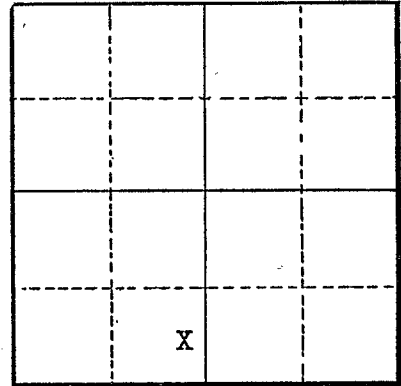

Section 24

Altitude at well

TYPE OF WELL: Drilled Date Constructed 8/15/53

Depth drilled 138 ft. Depth cased 138 ft.

### CASING RECORD:

8 inch steel casing set to 138 feet

### FINISH:

12 rows, 8 to row - 96 cuts from 119' to 129'

### AQUIFERS:

### WATER LEVEL:

25 ft. below surface

PUMPING EQUIPMENT: Type Fairbanks Morse turbine H.P. 25  
Capacity 450 G.P.M.

### WELL TESTS:

Drawdown	6'	ft. after	hours	115	G.P.M.
Drawdown	24'	ft. after	hours	570	G.P.M.

USE OF WATER Irrigation Temp. °F., 19

SOURCE OF INFORMATION Well Registration Statement Cert. # GR-3533

DRILLER or DIGGER

### ADDITIONAL DATA:

Log  Water Level Measurements  Chemical Analysis  Aquifer Test

### REMARKS:

Log:

Top soil silt  
Blue shale  
Sand shale  
Blue shale  
Sand & shale  
Sand & gravel (water)

Top to 33 ft.  
33 to 72  
72 to 82  
82 to 96  
96 to 117  
117 to 137