

STATE ENGINEER
Salem, Oregon

MARI... 2663

Well Record

STATE WELL NO. 5/2W-25F
COUNTY MARION
APPLICATION NO. GR-2354

OWNER: Philip V. Berning

MAILING ADDRESS:


LOCATION OF WELL: Owner's No.

CITY AND STATE: Gervais, Oregon

SE 1/4 NW 1/4 Sec. 25 T. 5 S., R. 2 W., W.M.

Bearing and distance from section or subdivision

corner 5 ch. S. & 4 Ch. E.

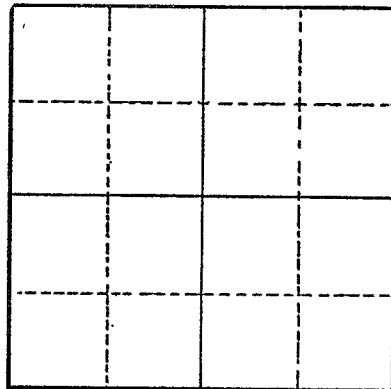

Section

Altitude at well 180

TYPE OF WELL: Drilled Date Constructed 1952

Depth drilled 143 Depth cased 143

CASING RECORD:

10-inch

FINISH:

Mills perforated starting from bottom to 130 up.

AQUIFERS:

Topsoil, silt, shale and sand

WATER LEVEL:

13 1/2-feet

PUMPING EQUIPMENT: Type Jacuzzi Turbine H.P. 5
Capacity 150 G.P.M.

WELL TESTS:

Drawdown 28 ft. after hours Pumping 140 G.P.M.

Drawdown 73 ft. after hours Pumping 400 G.P.M.

USE OF WATER Irrigation - 48 acres, Temp. °F., 19

SOURCE OF INFORMATION GR-2236

DRILLER or DIGGER

ADDITIONAL DATA:

Log Water Level Measurements Chemical Analysis Aquifer Test

REMARKS:

| | |
|--------------------------|-----|
| Topsoil & silt & subsoil | 29' |
| Blue Shale | 68 |
| Black sand | 84 |
| Blue gray shale | 122 |
| Gravel shale (tight) | 130 |
| Gravel & Sand (water) | 143 |

Still in the same gravel when we finished.