

STATE ENGINEER
Salem, Oregon

MARI.....

Well Record

STATE WELL NO. 5/2W-26G(2)
COUNTY Marion
APPLICATION NO. CR-218

OWNER: City of Gervais

MAILING
ADDRESS:


LOCATION OF WELL: Owner's No. #2

CITY AND
STATE:

Gervais, Oregon

SW 1/4 NE 1/4 Sec. 26 T. 5 S. R. 2 W., W.M.

Bearing and distance from section or subdivision
corner 150' N. & 60' E. from center of Sec. 26

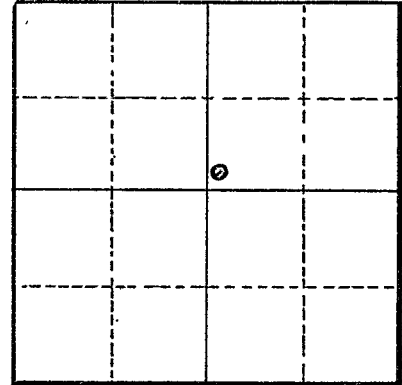

Section 26

Altitude at well 183.5' Interpolated

TYPE OF WELL: Drilled Date Constructed 1929

Depth drilled 140 Depth cased 140

CASING RECORD:

10 inch casing set from 0 to 140 feet

FINISH:

No record

AQUIFERS:

No record

WATER LEVEL:

40 feet below land surface

PUMPING EQUIPMENT: Type No record H.P. 25
Capacity 300 G.P.M.

WELL TESTS:

Drawdown ft. after hours pumping 300 G.P.M.

Drawdown ft. after hours G.P.M.

USE OF WATER Municipal Temp. °F. 19

SOURCE OF INFORMATION Registration Statement CR-218

DRILLER or DIGGER

ADDITIONAL DATA:

Log No Water Level Measurements Chemical Analysis Aquifer Test

REMARKS:

STATE ENGINEER
Salem, Oregon

State Well No. 5/2W-26G1

County Marion

Application No. _____

Chemical Analysis

OWNER City of Gervais OWNER'S NO. _____

ANALYST USGS Address Portland, Oregon

Date of Collection 6-1-60

Point of Collection _____

	P.P.M.	E.P.M.
Silica (SiO ₂)	49	
Iron (Fe) Total	1.2	
Manganese (Mn)		
Calcium (Ca)	24	
Magnesium (Mg)	18	
Sodium (Na)	15	
Potassium (K)	2.2	
Bicarbonate (HCO ₃)	195	
Carbonate (CO ₃)	0	
Sulfate (SO ₄)	.8	
Chloride (Cl)	3.8	
Fluoride (F)	.4	
Nitrate (NO ₃)	.2	
Boron (B)		
Dissolved Solids	211	
Hardness as CaCO ₃	133	
Specific Conductance (Micromhos at 25°C)	300	
pH	7.6	
Percent Sodium	19	
Sodium Absorption Ratio (S.A.R.)	.6	
CLASS		