

STATE ENGINEER
Salem, Oregon

2687
MARI.....

Well Record

STATE WELL NO. 5/2W-26P(1)
COUNTY Marion
APPLICATION NO. GR-1484

GR= 1433

OWNER: Henry Oswald Berning

MAILING ADDRESS:

Rt. 1, Box 2


LOCATION OF WELL: Owner's No.

CITY AND STATE:

Gervais, Oregon

SE 1/4 SW 1/4 Sec. 26 T. 5 S., R. 2 W., W.M.

Bearing and distance from section or subdivision corner 670' W. & 250' S. from NE cor. of SE 1/4 SW 1/4 of Sec. 26.

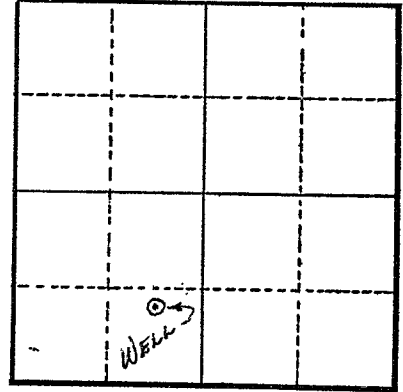

Section 26

Altitude at well 121

TYPE OF WELL: Drilled Date Constructed 1951

Depth drilled 136' Depth cased 136'

CASING RECORD:

10"

FINISH:

Mills perforations from 124' to 136'

AQUIFERS:

WATER LEVEL:

30' (9- -51)

PUMPING EQUIPMENT: Type Jacuzzi turbine
Capacity 450 G.P.M.

H.P. 20

WELL TESTS:

Drawdown 87 ft. after hours 720 G.P.M.
Drawdown ft. after hours G.P.M.

USE OF WATER Irrigation Temp. °F. 19

SOURCE OF INFORMATION GR Record

DRILLER or DIGGER Wymore

ADDITIONAL DATA:

Log N.A. Water Level Measurements Chemical Analysis Aquifer Test

REMARKS:

Irrigation of 49.2 acres.