

STATE ENGINEER
Salem, Oregon

MARI 2698

Well Record


STATE WELL NO. 5/2W-27P(1)
COUNTY Marion
APPLICATION NO. GR-788

OWNER: Frank J. Gratsinger MAILING ADDRESS: _____

LOCATION OF WELL: Owner's No. #2 CITY AND STATE: Gervais, Oregon

SE 1/4 SW 1/4 Sec. 27 T. 5 N. S., R. 2 W., W.M.

Bearing and distance from section or subdivision corner 3150' W & 450' N from NE corner of section 34.

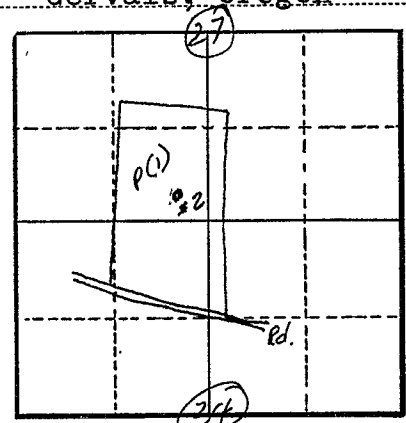

Section 27

Altitude at well 182 feet

TYPE OF WELL: Drilled Date Constructed May 14, '54

Depth drilled 140 ft. Depth cased 140 ft.

CASING RECORD:

10 inch

FINISH:

13 Perforations per ft. size 1/2" x 4" 127 to 137 ft.

AQUIFERS:

Gravel from 117 to 140

WATER LEVEL:

18 feet (5-14-54)

PUMPING EQUIPMENT: Type Three Ph. Eledt. - Peerless turbine H.P. 15

Capacity 340 G.P.M. 5 in.

WELL TESTS:

Drawdown	<u>5</u>	ft. after	_____	hours	<u>225</u>	G.P.M.
Drawdown	<u>15</u>	ft. after	_____	hours	<u>340</u>	G.P.M.

USE OF WATER Irrigation - 99 acres Temp. _____ °F. _____, 19_____

SOURCE OF INFORMATION GR-788

DRILLER or DIGGER _____

ADDITIONAL DATA:

Log Below. Water Level Measurements _____ Chemical Analysis _____ Aquifer Test _____

REMARKS:

Soil	<u>0 to 22'</u>
Sand	<u>22 to 117'</u>
Gravel	<u>117 to 140'</u>