

STATE ENGINEER
Salem, Oregon

MARI... 2715

Well Record


STATE WELL NO. 5/2W-28L
COUNTY Marion
APPLICATION NO. GR-3121

OWNER: Louis Schmerber
MAILING ADDRESS: Route 1, Box 47

LOCATION OF WELL: Owner's No. _____
CITY AND STATE: Gervais, Oregon

NE 1/4 SW 1/4 Sec. 28 T. 5 ~~N.~~ ~~E.~~ S., R. 2 W., W.M.

Bearing and distance from section or subdivision corner 100' S. and 150' W.

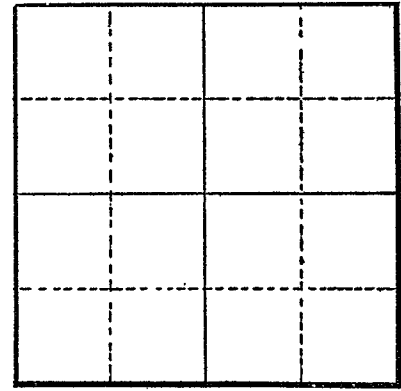

Section

Altitude at well _____

TYPE OF WELL: drilled Date Constructed 1952

Depth drilled 130' Depth cased 130'

CASING RECORD:

6"

FINISH:

2 6" x 1/4" from 40 to 60'
2 6" x 1/4" from 100' to 125'

AQUIFERS:

clay, silt, sand, gravel

WATER LEVEL:

12'

PUMPING EQUIPMENT: Type Johnson Turbine H.P. 10
Capacity 200 G.P.M.

WELL TESTS:

Drawdown 13 ft. after _____ hours pumping 285 G.P.M.
Drawdown _____ ft. after _____ hours _____ G.P.M.

USE OF WATER Irrigation & stock Temp. °F. _____, 19

SOURCE OF INFORMATION GR-3166

DRILLER or DIGGER _____

ADDITIONAL DATA:

Log Water Level Measurements _____ Chemical Analysis _____ Aquifer Test _____

REMARKS:

clay	12	12
silt	18	30
fine sand	50	80
course sand	22	102
gravel and sand	28	130