

STATE ENGINEER
Salem, Oregon

MARI...2751

Well Record

STATE WELL NO. 5/2W-30A(1)
COUNTY Marion
APPLICATION NO.

OWNER: Oliver Rubens


MAILING ADDRESS: Pg 2 of 3

LOCATION OF WELL: Owner's No.

CITY AND STATE:

1/4 Sec. T. N. S., R. E. W., W.M.

Bearing and distance from section or subdivision corner

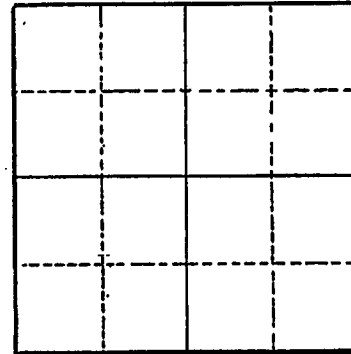

Section

Altitude at well 176

TYPE OF WELL: Drilled Date Constructed 1959

Depth drilled 111 Depth cased 111

CASING RECORD:
6 inch

FINISH:

Open bottom, casing unperforated

AQUIFERS:

Black sand and gravel from 105 to 111

WATER LEVEL:

33 feet below land surface, August, 1959

PUMPING EQUIPMENT: Type Jet H.P.
Capacity G.P.M.

WELL TESTS:

Drawdown ft. after hours G.P.M.
Drawdown ft. after hours G.P.M.

USE OF WATER Domestic Temp. °F., 19

SOURCE OF INFORMATION USGS

DRILLER or DIGGER

ADDITIONAL DATA:

Log X Water Level Measurements Chemical Analysis Aquifer Test

REMARKS:

Temperature 56° F.

