

STATE ENGINEER  
Salem, Oregon

MARI... 2752

# Well Record

STATE WELL NO. ...5/2W-30E...  
COUNTY ...Marion...  
APPLICATION NO. GR-1487

GR- 1436

OWNER: F. Ralph DuRette


MAILING ADDRESS: Rt. 1, Box 266

LOCATION OF WELL: Owner's No.

CITY AND STATE: Gervais, Oregon

SW 1/4 NW 1/4 Sec. 30 T. 5 S. R. 2 W., W.M.

Bearing and distance from section or subdivision corner 1100' N. & 900' E. from Pt. cor. Sec. 25 T. 5S. R. 3W. W.M.

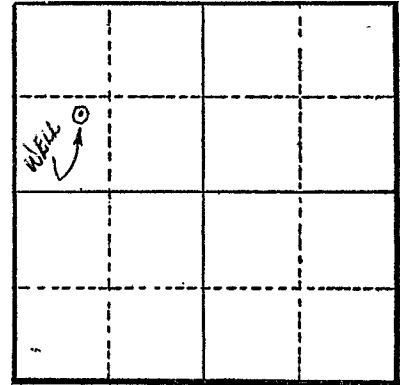

Section 30

Altitude at well 100'

TYPE OF WELL: Drilled Date Constructed 1949

Depth drilled 53' Depth cased 53'

### CASING RECORD:

10"

### FINISH:

Perforated from 35' to 53'

### AQUIFERS:

*Sand & gravel from 21 to 53*

### WATER LEVEL:

6' (7-49)

PUMPING EQUIPMENT: Type Pacific Cent. H.P. 20  
Capacity 560 G.P.M.

### WELL TESTS:

Drawdown 3 ft. after 500 hours G.P.M.  
Drawdown ft. after hours G.P.M.

USE OF WATER Irrigation Temp. °F., 19

SOURCE OF INFORMATION GR Record

DRILLER or DIGGER J. T. Miller

### ADDITIONAL DATA:

Log Water Level Measurements Chemical Analysis Aquifer Test

### REMARKS:

Log: Clay 0 to 9'  
Sand 9' to 21'  
Sand & rock 21' to 53'

Irrigation of 157 acres.