

STATE ENGINEER  
Salem, Oregon

MARI.....<sup>2754</sup>

# Well Record


STATE WELL NO. 5/2W-30M(1)  
COUNTY Marion  
APPLICATION NO. GR-116

OWNER: Carter J. Keene MAILING ADDRESS:

LOCATION OF WELL: Owner's No. 1 CITY AND STATE: Gervais, Oregon

NW 1/4 SW 1/4 Sec. 30 T. 5 S., R. 2 W., W.M.

Bearing and distance from section or subdivision corner 750' E. & 400' S. from W 1/4 cor. Sec. 30

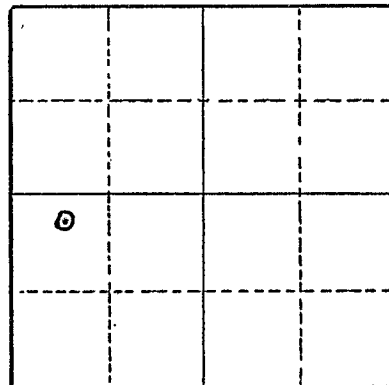

Section 30

Altitude at well 100' Interpolated

TYPE OF WELL: Drilled Date Constructed 1945

Depth drilled 45 Depth cased 27

### CASING RECORD:

10 inch steel casing set from 0 to 45 feet

### FINISH:

Perforations set from 27 to 45 feet

### AQUIFERS:

Gravel 27 to 45 feet

### WATER LEVEL:

8 feet below land surface Flows in winter

PUMPING EQUIPMENT: Type 3" centrifugal H.P. 40  
Capacity 600 G.P.M.

### WELL TESTS:

Drawdown ft. after hours G.P.M.  
Drawdown ft. after hours G.P.M.

USE OF WATER Irrigation 109 acres Temp. °F., 19

SOURCE OF INFORMATION Registration Statement GR-116

DRILLER or DIGGER Wymore Well Drillers

### ADDITIONAL DATA:

Log  Water Level Measurements Chemical Analysis Aquifer Test

### REMARKS:

Log: Silt 0-27 feet  
Gravel 27-45 feet