

STATE ENGINEER  
Salem, Oregon

2755  
MARI.....

# Well Record

STATE WELL NO. 5/2W - 30R(U)  
COUNTY MARION  
APPLICATION NO. GR-1987

OWNER: Stanley J. and Rose Michalek


MAILING ADDRESS: Rt. 1, Box 40

LOCATION OF WELL: Owner's No.

CITY AND STATE: Gervais, Oregon

SE 1/4 SE 1/4 Sec. 30 T. 5 S., R. 2 W., W.M.

Bearing and distance from section or subdivision corner 1056' W. & 230' N.

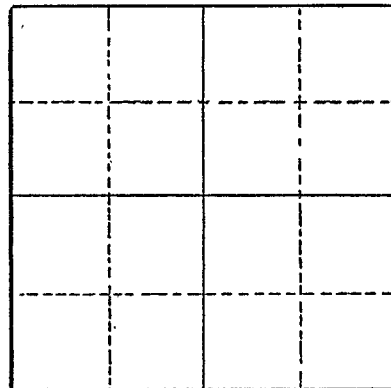

Section

Altitude at well

TYPE OF WELL: Drilled Date Constructed 1946

Depth drilled 105 Depth cased Est. 105

### CASING RECORD:

6-inch

### FINISH:

### AQUIFERS:

Sand

### WATER LEVEL:

24-feet 19' (8 - - 46)

PUMPING EQUIPMENT: Type Jacuzzi Jet H.P. 5  
Capacity 60 G.P.M.

### WELL TESTS:

Drawdown 19 ft. after hours Pumping 50 G.P.M.  
Drawdown 47 ft. after hours Pumping 100 G.P.M.

USE OF WATER Irrigation - 9 acres Temp. °F., 19

SOURCE OF INFORMATION GR-1918

DRILLER or DIGGER

### ADDITIONAL DATA:

Log  Water Level Measurements Chemical Analysis Aquifer Test

### REMARKS:

Clay 64 to 80  
Slimy sand 16 to 80  
Black sand 18 to 98  
sand and gravel 6 to 104  
gravel (loose) 1 to 105