

STATE ENGINEER
Salem, Oregon

MARI 2777

Well Record


STATE WELL NO. 5/2W-31D(1)
COUNTY Marion
APPLICATION NO. GR-105

OWNER: Louis Schmerber
MAILING ADDRESS: _____

LOCATION OF WELL: Owner's No. _____
CITY AND STATE: Gervais, Oregon

NW 1/4 NW 1/4 Sec. 31 T. 5 N. S. R. 2 W., W.M.

Bearing and distance from section or subdivision corner 5 chains S. & 15 chains E. from NW cor. Sec. 31

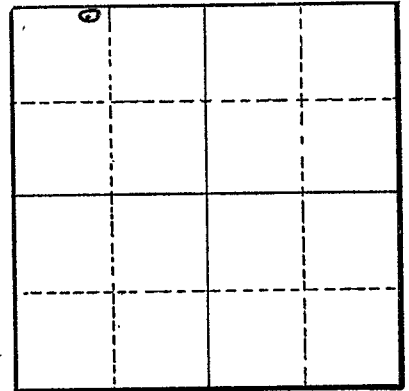

Section 31

Altitude at well 140' Interpolated

TYPE OF WELL: Drilled Date Constructed 7-1-52

Depth drilled 94 Depth cased 94

CASING RECORD:

12 inch steel casing set from plus 6" to 94 feet

FINISH:

8" x 1/4" x 1/8" perforations set 4" (horizontal) from 74 to 94 feet

AQUIFERS:

Sand and gravel from 91 1/2 to 94 feet

WATER LEVEL:

18 feet below land surface 8/2/52

PUMPING EQUIPMENT: Type 5" Jacuzzi turbine H.P. 30
Capacity 450 G.P.M.

WELL TESTS:

Drawdown 65 ft. after _____ hours 450 G.P.M.
Drawdown 35 ft. after _____ hours 200 G.P.M.

USE OF WATER Irrigation 75 acres Temp. _____ °F. _____, 19

SOURCE OF INFORMATION Registration Statement GR-105

DRILLER or DIGGER Northwest Drilling Co. - Defunct

ADDITIONAL DATA:

Log Water Level Measurements _____ Chemical Analysis _____ Aquifer Test _____

REMARKS:

