

STATE ENGINEER
Salem, Oregon

2782
MARI.....

Well Record

STATE WELL NO. 5/2W-31L(1)
COUNTY Marion
APPLICATION NO. GR-135
5

OWNER: E. D. Grassman


MAILING ADDRESS: Rt. 1

LOCATION OF WELL: Owner's No.

CITY AND STATE: Gervais, Oregon

NE 1/4 SW 1/4 Sec. 31 T. 5 N. S. R. 2 W., W.M.

Bearing and distance from section or subdivision corner 900' W. & 60' S. from center of Sec. 31

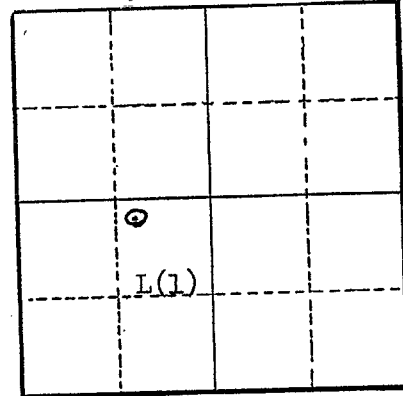

Altitude at well 175' Interpolated

TYPE OF WELL: Drilled Date Constructed April '51

Depth drilled 85 Depth cased 85

Section

CASING RECORD:

12 inch casing set from 0 to 85 feet

FINISH:

Gravel packed from 65 to 85 feet

AQUIFERS:

Unknown

WATER LEVEL:

40 feet below land surface April 1951

PUMPING EQUIPMENT: Type Peerless turbine H.P. 30
Capacity 600 G.P.M.

WELL TESTS:

Drawdown ft. after hours G.P.M.
Drawdown ft. after hours G.P.M.

USE OF WATER Irrigation 32.26 acres Temp. °F., 19.

SOURCE OF INFORMATION Registration Statement GR-135

DRILLER or DIGGER

ADDITIONAL DATA:

Log No. Water Level Measurements Chemical Analysis Aquifer Test

REMARKS:

STATE ENGINEER
Salem, Oregon

State Well No. 5/2W-3140

County Marion

Application No. _____

Water Level Record

OWNER: P OWNER'S NO. _____

Description of measuring point: Bottom of slot in east side of casing which
is .8 feet above LSD. (Domestic pump-pipe slot)

Date	Water Level Feet (above) (below) Land Surface	Remarks	Date	Water Level Feet (above) (below) Land Surface	Remarks
5/30/57	22.86	WSB			
10-15-57	28.52	WSB			

REMARKS: Irrig. & Domestic Well