

STATE ENGINEER
Salem, Oregon

2783
MARI.....

Well Record


STATE WELL NO. 5/2W-31M
COUNTY Marion
APPLICATION NO. GR-1948

OWNER: Robert and Juanita Zielinski
MAILING ADDRESS: Route 1, Box 59

LOCATION OF WELL: Owner's No. _____
CITY AND STATE: Gervais, Oregon

NW 1/4 SW 1/4 Sec. 31 T. 5 N. S. R. 2 E. W., W.M.

Bearing and distance from section or subdivision
corner along Wheatland Road and Salem St. Paul Highway
11 miles north of Salem 1/2 mile west on Wheatland Road.

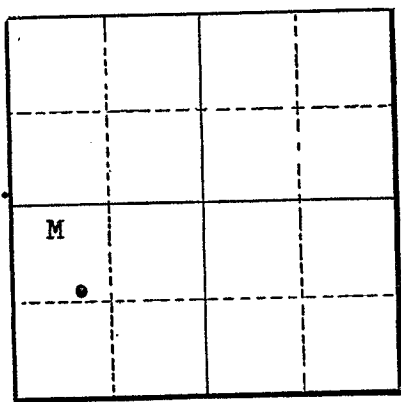

Section 31

Altitude at well _____

TYPE OF WELL: Drilled Date Constructed 1949

Depth drilled 104 feet Depth cased 100 feet

CASING RECORD:

10-inch casing set from 1 to 100 feet

FINISH:

perforated at 13 feet and 63 feet

AQUIFERS:

WATER LEVEL:

13 feet

PUMPING EQUIPMENT: Type Fairbanks Morse H.P.
Capacity 500 G.P.M.

WELL TESTS:

Drawdown 90 ft. after 400 hours G.P.M.
Drawdown 60 ft. after 275 hours G.P.M.

USE OF WATER Irrigation Temp. °F. 19

SOURCE OF INFORMATION GR-4095
DRILLER or DIGGER Max Wymore

ADDITIONAL DATA:
Log (NA) Water Level Measurements Chemical Analysis Aquifer Test

REMARKS: