

STATE ENGINEER
Salem, Oregon

MARI 2792 Well Record

STATE WELL NO. 5/2W-32B
COUNTY Marion
APPLICATION NO. GR-3813
G6849

OWNER: Roger Ray Welty

MAILING ADDRESS: Route 1, Box 133


LOCATION OF WELL: Owner's No.

CITY AND STATE: Gervais, Oregon

P 1 of 3

NW 1/4 NE 1/4 Sec. 32 T. 5 N. S. R. 2 E. W., W.M.

Bearing and distance from section or subdivision corner 750 feet South and 110 feet East from N/4 Corner, Section 32.

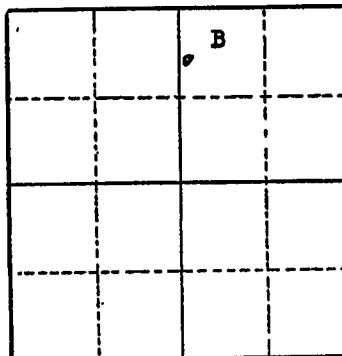

Section 32.

Altitude at well 184 feet

TYPE OF WELL: Drilled Date Constructed 4-4-52

Depth drilled 123 feet Depth cased 123 feet

CASING RECORD:

8-inch diameter set from 0 to 123 feet

FINISH:

1/4 perforation and 5 perforations to foot from 111 to 123 feet

AQUIFERS:

clay, shale, sand, and gravel

WATER LEVEL:

35 feet

PUMPING EQUIPMENT: Type Berkeley - Turbine H.P.
Capacity G.P.M.

WELL TESTS:

Drawdown 46 ft. after 420 hours G.P.M.
Drawdown 32 ft. after 300 hours G.P.M.

USE OF WATER Irrigation Temp. °F., 19

SOURCE OF INFORMATION GR-4101

DRILLER or DIGGER

ADDITIONAL DATA:

Log x Water Level Measurements Chemical Analysis Aquifer Test

REMARKS:

top soil and sub soil - no water 2 2
yellow clay or shale - no water 39 41
blue clay or shale - no water 49 90
blue clay and large gravel - no water 20 110
sand and gravel - all water bearing 13 123

STATE ENGINEER
Salem, Oregon

MARI 2792

Well Record

STATE WELL NO. 5/2W-320(2)
COUNTY Marion
APPLICATION NO.


OWNER: Roger Welty

MAILING ADDRESS: Pg 2 of 3

LOCATION OF WELL: Owner's No. CITY AND STATE:

..... 1/4 1/4 Sec. T. N. S, R. E. W., W.M.

Bearing and distance from section or subdivision corner

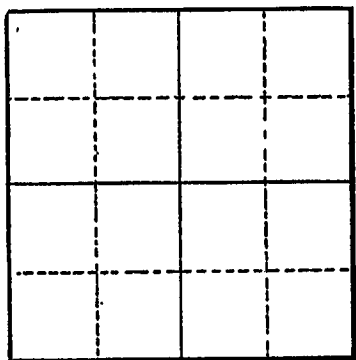

Altitude at well 178

TYPE OF WELL: Drilled Date Constructed 1952

Depth drilled 123 Depth cased 123

Section

CASING RECORD:
8 inch

FINISH:

Casing perforated 111 to 123

AQUIFERS:

Sand and gravel from 110 to 123

WATER LEVEL:

PUMPING EQUIPMENT: Type Turbine H.P.
Capacity G.P.M.

WELL TESTS:
Drawdown ft. after hours G.P.M.
Drawdown ft. after hours G.P.M.

USE OF WATER Irrigation Temp. °F., 19

SOURCE OF INFORMATION USGS

DRILLER or DIGGER

ADDITIONAL DATA:
Log Water Level Measurements Chemical Analysis Aquifer Test

REMARKS:

