

STATE ENGINEER
Salem, Oregon

MAR 27 1955

Well Record

STATE WELL NO. 5/2W-32E(1)
COUNTY Marion
APPLICATION NO.

OWNER: Paul Knapp


MAILING ADDRESS:

LOCATION OF WELL: Owner's No.

CITY AND STATE:

..... 1/4 1/4 Sec. T. N. S., R. E. W., W.M.

Bearing and distance from section or subdivision corner

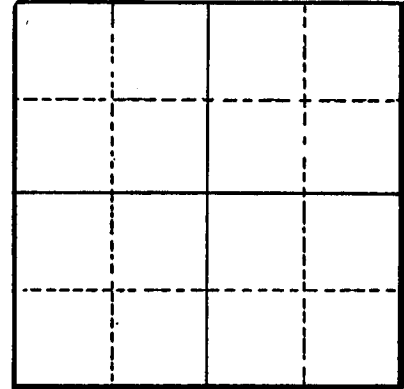

Section

Altitude at well 178

TYPE OF WELL: Drilled Date Constructed 1955

Depth drilled 106 Depth cased 106

CASING RECORD:

6 inch

FINISH:

AQUIFERS:

Sand and gravel

WATER LEVEL:

24 feet below land surface, June, 1955

PUMPING EQUIPMENT: Type Jet H.P. 1 1/2
Capacity G.P.M.

WELL TESTS:

Drawdown ft. after hours G.P.M.
Drawdown ft. after hours G.P.M.

USE OF WATER Domestic, Irr.--10 acres Temp. °F., 19

SOURCE OF INFORMATION USGS

DRILLER or DIGGER

ADDITIONAL DATA:

Log Water Level Measurements Chemical Analysis Aquifer Test

REMARKS: