

STATE ENGINEER  
Salem, Oregon

MARY 2807

# Well Record

STATE WELL NO. 5/2W-33D  
COUNTY Marion  
APPLICATION NO. GR-4010

OWNER: Thad E. Stevens, Jr.


MAILING ADDRESS: Route 2, Box 102

LOCATION OF WELL: Owner's No.

CITY AND STATE: Sherwood, Oregon

NW 1/4 NW 1/4 Sec. 33 T. 5 S., R. 2 W., W.M.

Bearing and distance from section or subdivision  
corner 1200' S. & 175' E. from NW Cor. Sec. 33

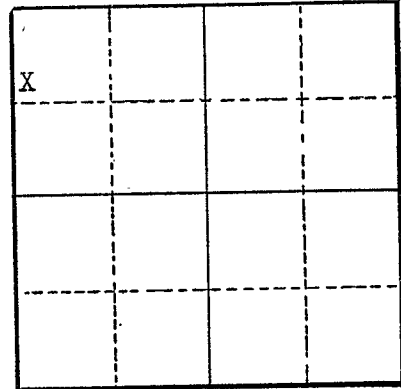

Section 33

Altitude at well

TYPE OF WELL: Drilled Date Constructed 1952

Depth drilled 155 ft. Depth cased 155 ft.

### CASING RECORD:

10 inch steel casing set to 155 feet

### FINISH:

### AQUIFERS:

### WATER LEVEL:

50 feet below surface

PUMPING EQUIPMENT: Type Jacuzzi turbine H.P. 20  
Capacity 350 G.P.M.

### WELL TESTS:

Drawdown ft. after hours G.P.M.  
Drawdown ft. after hours G.P.M.

USE OF WATER Irrigation Temp. °F., 19

SOURCE OF INFORMATION Well Registration Statement, Cert. # GR-3616

DRILLER or DIGGER Orvil Wymore

### ADDITIONAL DATA:

Log Water Level Measurements Chemical Analysis Aquifer Test

### REMARKS: