

STATE ENGINEER
Salem, Oregon

MAR. 28 1949

Well Record


STATE WELL NO. 5/2W-33M(1)
COUNTY Marion
APPLICATION NO.

OWNER: Paul Knapp
MAILING ADDRESS:

LOCATION OF WELL: Owner's No. CITY AND STATE:

1/4 1/4 Sec. T. N. E. S., R. W., W.M.

Bearing and distance from section or subdivision corner

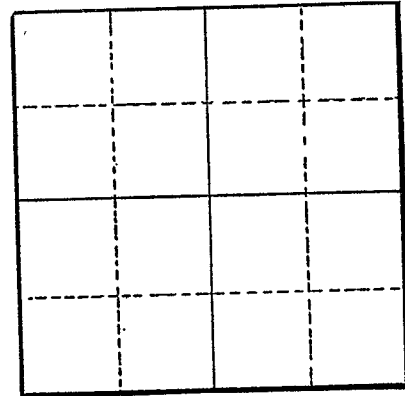

Section

Altitude at well 182

TYPE OF WELL: Drilled Date Constructed 1949

Depth drilled 65 Depth cased 65

CASING RECORD:

12 inch

FINISH:

Open bottom, casing unperforated

AQUIFERS:

Sand from 60 to 65

WATER LEVEL:

17.18 feet below land surface on July 26, 1960

PUMPING EQUIPMENT: Type Centrifugal H.P. 5
Capacity G.P.M.

WELL TESTS:

Drawdown ft. after hours G.P.M.
Drawdown ft. after hours G.P.M.

USE OF WATER Stock, Irrigation-17 acres Temp. °F., 19

SOURCE OF INFORMATION USGS

DRILLER or DIGGER

ADDITIONAL DATA:

Log Water Level Measurements Chemical Analysis Aquifer Test

REMARKS:

Tile casing.