

STATE ENGINEER
Salem, Oregon

Well Record

STATE WELL NO. 5/2W-34C(1)
COUNTY Marion
APPLICATION NO. GR-787


2825
MAR 21 1949

OWNER: Frank J. Gratsinger Mailing Address:

LOCATION OF WELL: Owner's No. #1 CITY AND STATE: Gervais, Oregon

NE 1/4 NW 1/4 Sec. 34 T. 5 N. S. R. 2 W., W.M.

Bearing and distance from section or subdivision corner 2850' W. & 750' S of NE corner of section 34.

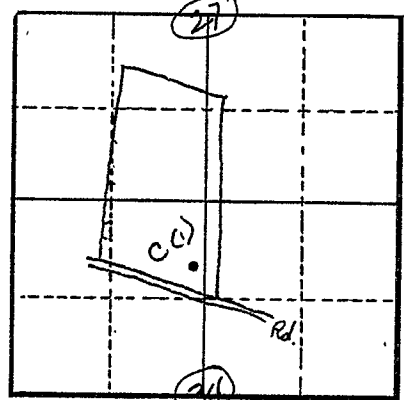

Section 34

Altitude at well 182 feet

TYPE OF WELL: Drilled Date Constructed Oct. 1949

Depth drilled 137 ft. Depth cased 137 ft.

CASING RECORD:

8 inch

FINISH:

AQUIFERS:

Gravel from 117 to 137

WATER LEVEL:

18 feet (10-50)

PUMPING EQUIPMENT: Type Single Ph. Elect. Peerless turbine H.P. 7 1/2
Capacity 200 G.P.M. 4 in.

WELL TESTS:

Drawdown 12 ft. after 200 hours G.P.M.
24 ft. after 350 hours G.P.M.

USE OF WATER Irrigation - 99 acres Temp. °F. 19

SOURCE OF INFORMATION GR-787

DRILLER or DIGGER

ADDITIONAL DATA:

Log Below Water Level Measurements Chemical Analysis Aquifer Test

REMARKS:

Soil 0 to 20'
Sand 20 to 117'
Gravel 117 to 137'