

STATE ENGINEER
Salem, Oregon

MARI..... 2857

Well Record


STATE WELL NO. 5/2W-35E(1)
COUNTY Marion
APPLICATION NO.

OWNER: Frank Adelman
MAILING ADDRESS:

LOCATION OF WELL: Owner's No. CITY AND STATE:

1/4 1/4 Sec. T. N. S., R. E. W., W.M.

Bearing and distance from section or subdivision corner

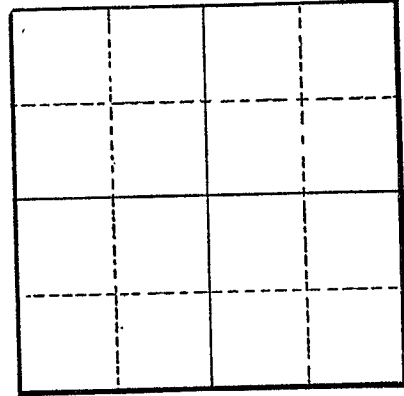

Section

Altitude at well 182

TYPE OF WELL: Drilled Date Constructed 1951

Depth drilled 134 Depth cased 134

CASING RECORD:

10 inch

FINISH:

Casing perforated 120-134

AQUIFERS:

Sand and gravel from 123 to 134

WATER LEVEL:

25 feet below land surface on September 12, 1951

PUMPING EQUIPMENT: Type Turbine H.P. 10
Capacity G.P.M.

WELL TESTS:

Drawdown ft. after hours G.P.M.
Drawdown ft. after hours G.P.M.

USE OF WATER Irrigation-57 acres Temp. °F. 19

SOURCE OF INFORMATION USGS

DRILLER or DIGGER

ADDITIONAL DATA:

Log Water Level Measurements Chemical Analysis Aquifer Test

REMARKS: