

STATE ENGINEER
Salem, Oregon

2858
MARI.....

Well Record


STATE WELL NO. 5/2W-35F
COUNTY Marion
APPLICATION NO. GR-898

OWNER: Frank P. Adelman Jr.
MAILING ADDRESS: Rt. 1, Box 147

LOCATION OF WELL: Owner's No. _____
CITY AND STATE: Gervais, Oregon

SE 1/4 NW 1/4 Sec. 35 T. 5 N. S., R. 2 W., W.M.

Bearing and distance from section or subdivision
corner 2840' N. 1° 15' E. SE cor. Sec. 34

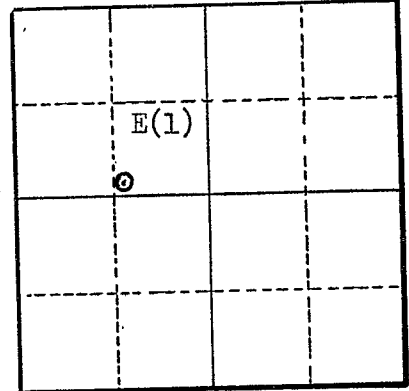

Section 35

Altitude at well 182

TYPE OF WELL: Drilled Date Constructed 1952

Depth drilled 134 Depth cased 134

CASING RECORD:

10" ID 31.20# 0 to 134

FINISH:

Mills perforator 70 perforations 120 to 134 feet

AQUIFERS:

Sand and gravel and water 123 to 134 feet

WATER LEVEL:

25

PUMPING EQUIPMENT: Type Peerless H.P. 10 Elec.
Capacity 200 G.P.M.

WELL TESTS:

Drawdown 35 ft. after 560 hours G.P.M.
Drawdown _____ ft. after _____ hours G.P.M.

USE OF WATER Irrigation Temp. °F. 19

SOURCE OF INFORMATION Owner
DRILLER or DIGGER Ray Perkins, Salem

ADDITIONAL DATA:

Log Water Level Measurements _____ Chemical Analysis _____ Aquifer Test _____

REMARKS:

