

STATE ENGINEER
Salem, Oregon

2859
MAR. 1954

Well Record

STATE WELL NO. 5/2W-35E(1)
COUNTY Marion
APPLICATION NO.

OWNER: Robert Harper


MAILING ADDRESS:

LOCATION OF WELL: Owner's No.

CITY AND STATE:

1/4 1/4 Sec. T. N. S., R. E. W., W.M.

Bearing and distance from section or subdivision corner

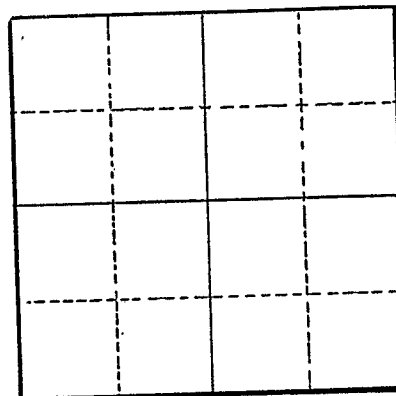

Section

Altitude at well 180

TYPE OF WELL: Drilled Date Constructed

Depth drilled 139 Depth cased

CASING RECORD:

8 inch

FINISH:

AQUIFERS:

Gravel

WATER LEVEL:

18 feet

PUMPING EQUIPMENT: Type Turbine H.P. 5
Capacity G.P.M.

WELL TESTS:

Drawdown ft. after hours G.P.M.
Drawdown ft. after hours G.P.M.

USE OF WATER Irrigation Temp. °F. 19
SOURCE OF INFORMATION USGS

DRILLER or DIGGER

ADDITIONAL DATA:

Log Water Level Measurements Chemical Analysis Aquifer Test

REMARKS:

Well 252 in Water-Supply Paper 890.