

STATE ENGINEER
Salem, Oregon

2881
MARI.....

Well Record


STATE WELL NO. 5/2W-36J(1)
COUNTY Marion
APPLICATION NO. GR-124

OWNER: Peter Prantl MAILING ADDRESS:

LOCATION OF WELL: Owner's No. 1 CITY AND STATE: Gervais, Oregon

NE 1/4 SE 1/4 Sec. 36 T. 5 N. S., R. 2 E. W., W.M.

Bearing and distance from section or subdivision corner 787' N. & 383' E. from SE cor. of NE 1/4 SE 1/4

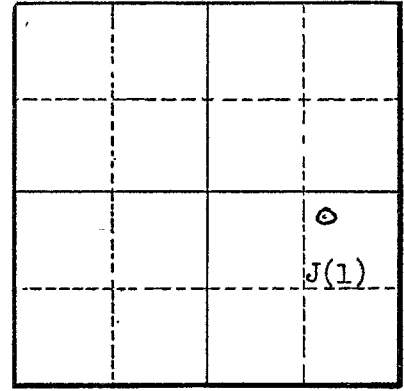

Section 36

Altitude at well 170' Interpolated

TYPE OF WELL: Drilled Date Constructed 3/1/52

Depth drilled 123 Depth cased 123

CASING RECORD:

10 inch casing set from 0 to 123 feet

FINISH:

8 perforations to the row 8" apart from 111 to 123 feet

AQUIFERS:

Sand and gravel from 111 to 123 feet

WATER LEVEL:

19 feet below land surface 4/3/52

PUMPING EQUIPMENT: Type Peerless turbine H.P. 15
Capacity 300 G.P.M.

WELL TESTS:

Drawdown 49 ft. after 250 hours G.P.M.
Drawdown 75 ft. after 350 hours G.P.M.

USE OF WATER Irrigation 63 acres Temp. °F., 19

SOURCE OF INFORMATION Registration Statement GR-124

DRILLER or DIGGER

ADDITIONAL DATA:

Log Water Level Measurements Chemical Analysis Aquifer Test

REMARKS:

