

STATE ENGINEER
Salem, Oregon

MARI. 2882

Well Record

STATE WELL NO. 5/2W-36K(1)
COUNTY Marion
APPLICATION NO. GR-1073

GR- 1035

OWNER: Raymond Zollner


MAILING ADDRESS: Rt. 1, Box 211

LOCATION OF WELL: Owner's No. #1

CITY AND STATE: Gervais, Oregon

NW 1/4 SE 1/4 Sec. 36 T. 5 S., R. 2 W., W.M.

Bearing and distance from section or subdivision corner 1900' W. & 300' S. from E¹ cor. Sec. 36.

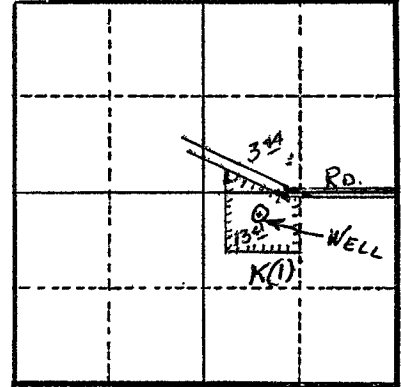

Section 36

Altitude at well 170 ft.

TYPE OF WELL: Drilled Date Constructed 1954

Depth drilled 140 ft. Depth cased 140 ft.

CASING RECORD:

10 inch

FINISH:

Perforated from 118 to 134 ft.

AQUIFERS:

WATER LEVEL:

31 ft. 26.12 (1-21-60)

PUMPING EQUIPMENT: Type Jacuzzi turbine H.P. 15

Capacity 180 G.P.M.

WELL TESTS:

Drawdown	85	ft. after	hours	140	G.P.M.
Drawdown	105	ft. after	hours	225	G.P.M.
Drawdown	125	ft. after	hours	265	G.P.M.

USE OF WATER Irrigation Temp. °F. 19

SOURCE OF INFORMATION G.R. Record

DRILLER or DIGGER R. Stadel & Son

ADDITIONAL DATA:

Log Water Level Measurements Chemical Analysis Aquifer Test

REMARKS:

- Log: Dirt 0 to 40 ft.
- Muddy sand 40 to 60 ft.
- Blue clay 60 to 80 ft.
- Grey sand 80 to 108 ft.
- Cement gravel 108 to 118 ft.
- Loose water gravel 118 to 121 ft.
- Cement gravel 121 to 134 ft.
- Grey clay 134 to 140 ft.
- Grey sand 140 to 150 ft.

Irrigation of 16.99 acres.