
## The original and first low of this report are to filed with the MAY 1 2 1969

## WITER WELL REPORT

of this report are to MAY 121969 STATE WELL REPORT filed with the MAY 121969 STATE OF OREGON STATE ENGINEER, SALEM, OREGON 97310 NOT SET TO not write above this line) of well completion. SALEM OREGON

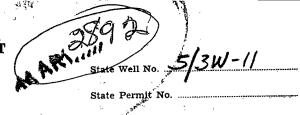

(11) OWNER:  Name OPAL PHIONY Address Ploure   Celonis Ore  Address Ploure   Celonis Ore  (2) TYPE OF WORK (check):  New Well Deepening Reconditioning Abandon Bearing and distance from section or subdivision corner  (3) TYPE OF WELL: (4) PROPOSED USE (check):  Rotary Driven Domestic Industrial Municipal Dug Bored Dirrigation Test Well Other Dug Bored Dirrigation Test Well Other Dug Bored Dirrigation Test Well Other Diam from Office Assing Interest County MPRION Driller's well number  (12) WELL LOG: Diameter of well below casing Depth drilled 63 ft. Depth of completed well 63 ft. Formation: Describe color, texture, grain size and structure of materials; and show thickness and nature of each stratum and aquiter penetrated, with at least one entry for each change of formation. Report each change in position of Static Water Level as drilling proceeds. Note drilling rates.  
Address ROUTE   Gellins One
Bearing and distance from section or subdivision corner
Casing Installed:   Casi
If abandonment, describe material and procedure in Item 12.  (3) TYPE OF WELL:  Rotary Driven Domestic

Dug
CASING INSTALLED:  Threaded Welded K  Threaded Melded K  Threaded Me
"Diam. from ft. to ft. Gage MATERIAL From To SWL  "Diam. from ft. to ft. Gage TOPSOIL O 3'  PERFORATIONS: Perforated? Yes □ No.    Diam. from ft. to ft. Gage TOPSOIL CLAY YELLOW SILTY 3 /8    BLACK SAND FINET
PERFORATIONS: Perforated? Yes   No.
PERFORATIONS: Perforated? Yes   No.
BLACK SAND ZINGT
Type of perforator used Alles
Size of perforations in. by 2 in. LOG. 71R SOLID. 28 30
240 perforations from 43 tt. to 52 tt. SAND + PEBBLES \$ - 30 35
48 perforations from 59 tt. to 62 tt. GRAVEL & SANDI" - 35 44
perforations from tt. to CRAVEL COARSE 49 53 66
perforations from ft. to SAND-BROWN MEDIUM. 53 58
perforations fromtt. tott. GRAVEL BLACK COARSE 58 62 6'6
(7) SCREENS: Well screen installed?   Yes   No
Manufacturer's Name
Type Model No.
Diam. Slot size Set from ft. to ft.
Diam. Slot size Set from ft. to ft.
(8) WATER LEVEL: Completed well.
Steald level 6'6' ft. below land surface Date 5-969
A sian pressure lbs. per square inch Date
(9) WELL TESTS:  Drawdown is amount water level is lowered below static level
Was a pump test made? Yes No If yes, by whom?  Work started 5 7 1969 Completed 5 - 9 1969
yield: gal./min. with ft. drawdown after hrs.
" Date well drilling machine moved off of well 7-19 6
" Drilling Machine Operator's Certification:
Bailer test 75 gal./min. with 2 ft. drawdown after / hrs. This well was constructed under my direct supervision. Materials used and information reported above are true to my best
Pate knowledge and belief.
Was a chemical analysis made? Tyes ANo [Signed] . Jule Date 5 19
(Drilling Machine Operator)
(10) CONSTRUCTION: Drilling Machine Operator's License No.
Well seal—Material used
Depth of seal
true to the heat of my Irneviledge and helief
Were any loose strata cemented off? Yes No Depth
Was a drive shoe used? Yes No  (Person, firm or corporation)  (Type or print)  Did any strata contain unusable water: Yes No  Add 3910 SILUERIUM EA SALER OR
Method of sealing strata off CASEA [Signed] (Water Well Contractor)
Was well gravel packed?   Yes No Size of grave:
Gravel placed from ft. to Contractor's License No. Date 77, 19