

STATE ENGINEER
Salem, Oregon

M 131... 2895

Well Record

STATE WELL NO. 5/3W-11L
COUNTY Marion
APPLICATION NO. GR-3105

OWNER: Mrs. James F. Mahony

MAILING ADDRESS: Route 1, Box 281


LOCATION OF WELL: Owner's No.

CITY AND STATE: Gervais, Oregon

NE 1/4 SW 1/4 Sec. 11 T. 5 N. S., R. 3 E. W., W.M.

Bearing and distance from section or subdivision corner S. 1022.32 feet, W. 3052.60 feet

Altitude at well

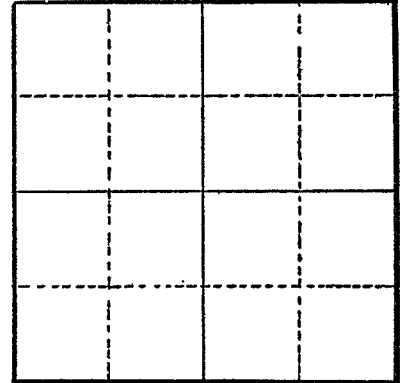

Section

TYPE OF WELL: Drilled Date Constructed 1953
Depth drilled 31 feet Depth cased 30.5 feet

CASING RECORD:

10-inch

FINISH:

12 - 3/8" x 1 1/2" perforations from 12 to 30

AQUIFERS:

Loam, sand, gravel

WATER LEVEL:

6 to 9 feet

PUMPING EQUIPMENT: Type Gould's Centrifugal H.P. 30
Capacity 600 G.P.M.

WELL TESTS:

Drawdown 4 ft. after hours Pumping 600 G.P.M.
Drawdown ft. after hours G.P.M.

USE OF WATER Irrigation Temp. °F., 19

SOURCE OF INFORMATION GR-2913

DRILLER or DIGGER Roy Perkins, Willamette Drilling Company

ADDITIONAL DATA:

Log Water Level Measurements Chemical Analysis Aquifer Test

REMARKS:

Sandy loam 12 12
Sand 2 14
Gravel 18.5 30.5