

STATE ENGINEER
Salem, Oregon

2897
MARION

Well Record


STATE WELL NO. 5/3W-11F
COUNTY MARION
APPLICATION NO. GR-2711

OWNER: A. W. Zyssel MAILING ADDRESS: Rt. 1,

LOCATION OF WELL: Owner's No. CITY AND STATE: Gervais, Oregon

SE 1/4 NW 1/4 Sec. 11 T. 5 S., R. 3 W., W.M.

Bearing and distance from section or subdivision corner 8.499 chains S. of NW corner of D.L.C. #70

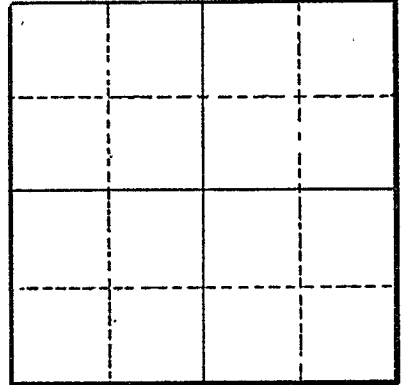

Section

Altitude at well

TYPE OF WELL: drilled Date Constructed 1948

Depth drilled 27 Depth cased 27

CASING RECORD:

8-inch

FINISH:

AQUIFERS:

Soil, sand and gravel

WATER LEVEL:

10-feet

PUMPING EQUIPMENT: Type G.E. Centrifugal H.P. 20
Capacity 400 G.P.M.

WELL TESTS:
Drawdown 10 ft. after hours Pumping 300 G.P.M.
Drawdown ft. after hours G.P.M.

USE OF WATER Irrigation Temp. °F., 19

SOURCE OF INFORMATION GR-2564

DRILLER or DIGGER

ADDITIONAL DATA:
Log X Water Level Measurements Chemical Analysis Aquifer Test

REMARKS:

Soil 8
Sand 2
Gravel Water Bearing 17