

STATE ENGINEER
Salem, Oregon

MAR 29 1951

Well Record


STATE WELL NO. 5/3W-25R
COUNTY MARION
APPLICATION NO. GR-884

OWNER: Lester & Viola mae Pearmine MAILING ADDRESS: Route 1, Box 50

LOCATION OF WELL: Owner's No. #1 CITY AND STATE: Gervais, Oregon

SE 1/4 SE 1/4 Sec. 25 T. 5 S., R. 3 W., W.M.

Bearing and distance from section or subdivision corner 1100' W. & 400' N. from SE cor. Sec. 5

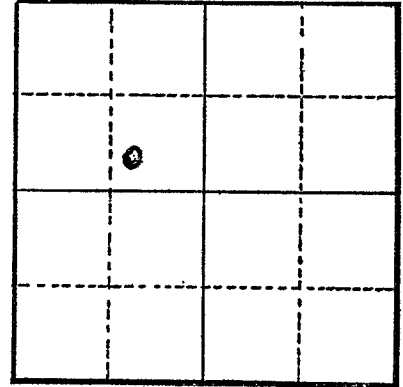

Section 25

Altitude at well 102

TYPE OF WELL: Drilled Date Constructed 11-15-51

Depth drilled 59 Depth cased 59

CASING RECORD:

12" steel 0 to 59'

FINISH:

AQUIFERS:

WATER LEVEL:
12' (November-1951)

PUMPING EQUIPMENT: Type Jacuzzi Turbine H.P. 20 Elec.
Capacity 500 G.P.M.

WELL TESTS:
Drawdown 65 ft. after hours 400 G.P.M.
Drawdown ft. after hours G.P.M.

USE OF WATER Irrigation 73 acres Temp. °F., 19

SOURCE OF INFORMATION Owner

DRILLER or DIGGER W. J. Davis

ADDITIONAL DATA:
Log NA Water Level Measurements Chemical Analysis Aquifer Test

REMARKS: