

STATE ENGINEER
Salem, Oregon

MARI.....²⁹³⁴

Well Record

STATE WELL NO. 5/3W - 34J
COUNTY MARION
APPLICATION NO. GR-2224

OWNER: Henry White Jr.


MAILING ADDRESS: Rt. 1, Box 95

LOCATION OF WELL: Owner's No. _____

CITY AND STATE: Gervais, Oregon

NE 1/4 SE 1/4 Sec. 34 T. 5 S., R. 3 W., W.M.

Bearing and distance from section or subdivision corner 100' W. and 470' S.

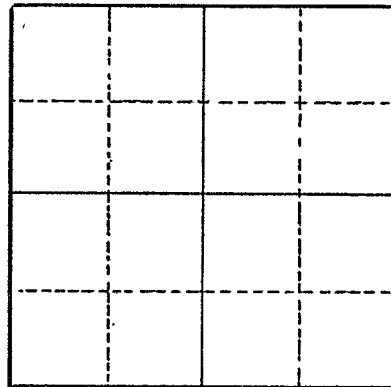

Section _____

Altitude at well _____

TYPE OF WELL: Drilled Date Constructed Prior 1955

Depth drilled 38 Depth cased 38

CASING RECORD:

10-Inch

FINISH:

Perforations from 18 to 38

AQUIFERS:

Sand and gravel

WATER LEVEL:

18-Feet

PUMPING EQUIPMENT: Type Fairbanks Morse Centrifugal H.P. 30
Capacity 800 G.P.M.

WELL TESTS:

Drawdown 6 ft. after _____ hours Pumping 6 G.P.M.

Drawdown _____ ft. after _____ hours _____ G.P.M.

USE OF WATER Irrigation Temp. _____ °F. _____, 19.

SOURCE OF INFORMATION GR-2130

DRILLER or DIGGER Fred Wymore, Willamette Well Drillers, Salem, Oregon

ADDITIONAL DATA:

Log Water Level Measurements _____ Chemical Analysis _____ Aquifer Test _____

REMARKS:

Sand and gravel