

STATE ENGINEER
Salem, Oregon


2935
MAR 1954
Well Record

STATE WELL NO. 5/3W-34J(1)
COUNTY MARION
APPLICATION NO. GR-454

OWNER: Fred Viasco
MAILING ADDRESS: Route 1, Box 105

LOCATION OF WELL: Owner's No. #3
CITY AND STATE: Gervais, Oregon

NE 1/4 SE 1/4 Sec. 34 T. 5 N. S, R. 3 W., W.M.
Bearing and distance from section or subdivision
corner 42.86' N. & 686.5' W. of most northerly
northeast cor. William Matheney DIC #76

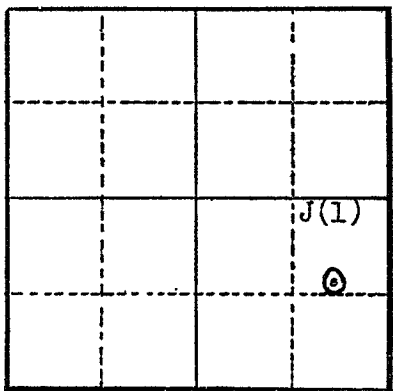

Section 34

Altitude at well 105 +

TYPE OF WELL: Drilled Date Constructed 4-30-47

Depth drilled 40 ? Depth cased 45 +

CASING RECORD:

10-inch

FINISH:

AQUIFERS:

Gravel from 35 to 40'

WATER LEVEL:

15+

PUMPING EQUIPMENT: Type Centrifugal H.P. 40
Capacity 600 G.P.M.

WELL TESTS:

Drawdown ft. after hours G.P.M.
Drawdown ft. after hours G.P.M.

USE OF WATER Irrigation 10 acres Temp. °F., 19

SOURCE OF INFORMATION GR-454

DRILLER or DIGGER

ADDITIONAL DATA:

Log Water Level Measurements Chemical Analysis Aquifer Test

REMARKS:

Sandy loam 0 to 10 feet
Sand and gravel 10 to 35 feet
Gravel 35 to 40 feet

Not used in 1960