

STATE ENGINEER
Salem, Oregon

2937
MAR 1947

Well Record

STATE WELL NO. 5/3W-34K(1)
COUNTY MARION
APPLICATION NO. GR-454

OWNER: Fred Viesko

MAILING ADDRESS: Route 1, Box 105

LOCATION OF WELL: Owner's No. #7


CITY AND STATE: Gervais, Oregon

NW 1/4 SE 1/4 Sec. 34 T. 5 N. S, R. 3 E. W., W.M.

Bearing and distance from section or subdivision corner N. 727.9' & W. 1320.6' from most

northerly northeast corner Matheny (?)

DLC #76

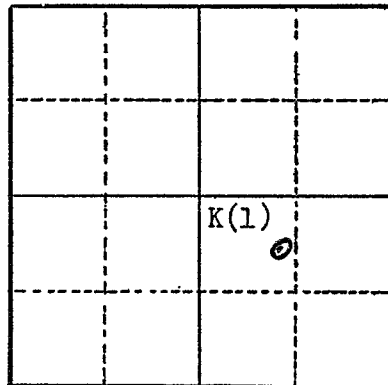

Section

Altitude at well 105 ±

TYPE OF WELL: Drilled Date Constructed 7-15-47

Depth drilled 40 ± Depth cased

CASING RECORD:

10-inch

FINISH:

AQUIFERS:

WATER LEVEL:

15 ±

PUMPING EQUIPMENT: Type Centrifugal H.P. 40
Capacity 550 G.P.M.

WELL TESTS:

Drawdown ft. after hours G.P.M.

Drawdown ft. after hours G.P.M.

USE OF WATER Irrigation 105 acres Temp. °F., 19

SOURCE OF INFORMATION GR-454

DRILLER or DIGGER

ADDITIONAL DATA:

Log Water Level Measurements Chemical Analysis Aquifer Test

REMARKS:

Sandy loam 0 to 6 feet
Gravel & sand 6 to 30 feet
Gravel 30 to 40 feet