

STATE ENGINEER
Salem, Oregon

2949
MARI....

Well Record

STATE WELL NO. 5/3W - 35N
COUNTY MARION
APPLICATION NO. GR-2223

OWNER: John Bushman, Ida M. Bushman


MAILING ADDRESS: Rt. 1, Box 94

LOCATION OF WELL: Owner's No.

CITY AND STATE: Gervais, Oregon

SW 1/4 SW 1/4 Sec. 35 T. 5 N. S. R. 3 W., W.M.

Bearing and distance from section or subdivision corner 410' E. and 580' N.

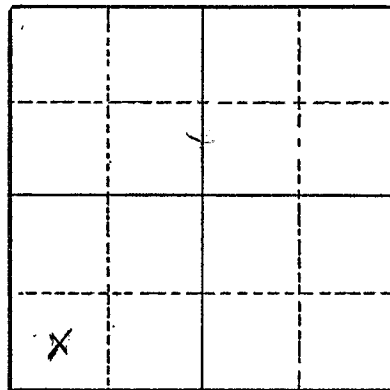

Altitude at well 110'

TYPE OF WELL: Drilled Date Constructed Prior to 1950

Depth drilled 38 Depth cased 38

Section

CASING RECORD:

10-Inch

FINISH:

Perforations from 28 to 30

AQUIFERS:

Sand and gravel

WATER LEVEL:

18-Feet

PUMPING EQUIPMENT: Type Centrifugal H.P. 40
Capacity 600 G.P.M.

WELL TESTS:

Drawdown 1 ft. after Pumping 400 hours G.P.M.
Drawdown ft. after hours G.P.M.

USE OF WATER Irrigation - 43 acres Temp. °F., 19

SOURCE OF INFORMATION GR-2128

DRILLER or DIGGER

ADDITIONAL DATA:

Log Water Level Measurements Chemical Analysis Aquifer Test

REMARKS:

Sand and gravel