

STATE ENGINEER
Salem, Oregon

Well Record

STATE WELL NO. 4/1W - 5J1
COUNTY MARION
APPLICATION NO. GR-1960

MARI-295

OWNER: W. L. Racette & R. Racette


MAILING ADDRESS: Aurora, Oregon

LOCATION OF WELL: Owner's No. _____

CITY AND STATE: _____

NE ¼ SE ¼ Sec. 5 T. 4 N. S., R. 1 E. W., W.M.

Bearing and distance from section or subdivision corner 1885' N. & 777' W.

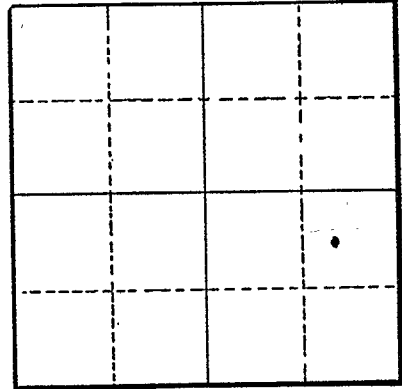

Section _____

Altitude at well _____

TYPE OF WELL: Drilled Date Constructed 1949

Depth drilled 162 Depth cased 142

CASING RECORD:

10-inch

FINISH:

Perforations from 80 to 90

Perforations from 110 to 115

Perforations from 130 to 136

AQUIFERS:

Gravel

WATER LEVEL:

8-feet

PUMPING EQUIPMENT: Type Peerless Turbine H.P. 30
Capacity 600 G.P.M.

WELL TESTS:

Drawdown 128 ft. after 4 hours pumping 1300 G.P.M.

Drawdown _____ ft. after _____ hours _____ G.P.M.

USE OF WATER Irrigation Temp. _____ °F., 19.

SOURCE OF INFORMATION GR-1888 by _____

DRILLER or DIGGER J. Beck, Canby

ADDITIONAL DATA:

Log Water Level Measurements _____ Chemical Analysis _____ Aquifer Test _____

REMARKS:

Sand & Gravel 5 to 115
Clay, blue
gravels
gravel, pea & clay open hole - water bearing 142 to 162