

STATE ENGINEER
Salem, Oregon

2982
MAR 1953

Well Record

STATE WELL NO. 6/1W-1N (1)
COUNTY Marion
APPLICATION NO. GR-353

OWNER: Walter Duda

MAILING

ADDRESS: Rt. 1, Box 16

CITY AND

STATE: Mt. Angel, Oregon


LOCATION OF WELL: Owner's No. #2

SW $\frac{1}{4}$ SW $\frac{1}{4}$ Sec. 1 T. 6 N. S. R. 1 E. W., W.M.

Bearing and distance from section or subdivision

corner 84.3' N. & 324.7' E. from S.E. Sec.

Cor. 2.

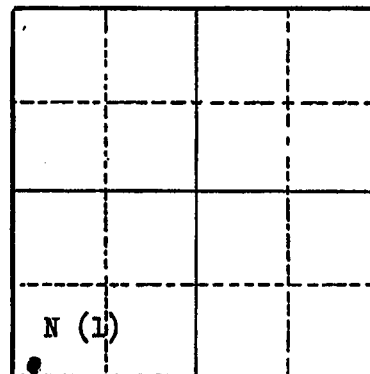

Section 1

Altitude at well 175-200

TYPE OF WELL: Drilled Date Constructed May 1953

Depth drilled 251 Depth cased 180

CASING RECORD:

8 inch

FINISH:

AQUIFERS:

WATER LEVEL:

59

PUMPING EQUIPMENT: Type Turbine

H.P. 10

Capacity 275 G.P.M.

WELL TESTS:

Drawdown ft. after hours G.P.M.

Drawdown ft. after hours G.P.M.

USE OF WATER Irrigation Temp. °F. 19

SOURCE OF INFORMATION Ground Water Registration Record

DRILLER or DIGGER

ADDITIONAL DATA:

Log ☒ Water Level Measurements Chemical Analysis Aquifer Test

REMARKS:

STATE ENGINEER
Salem, Oregon

State Well No. 6/1W-1N (1)
County Marion
Application No. GR-353

Well Log

Owner: Walter Duda Owner's No. #2

Driller: Date Drilled May 1953

[illegible]