

STATE ENGINEER  
Salem, Oregon

2985  
MARI...

# Well Record


STATE WELL NO. 6/1W-1R  
COUNTY Marion  
~~APPLICATION NO. GR-2110~~

OWNER: Carroll L. Ellison  
MAILING ADDRESS: Rt. 1, Box 103

LOCATION OF WELL: Owner's No. \_\_\_\_\_  
CITY AND STATE: Mt. Angel, Oregon

SE 1/4 SE 1/4 Sec. 1 T. 6 N. S, R. 1 W., W.M.

Bearing and distance from section or subdivision corner  
1330' N 19° 30' W

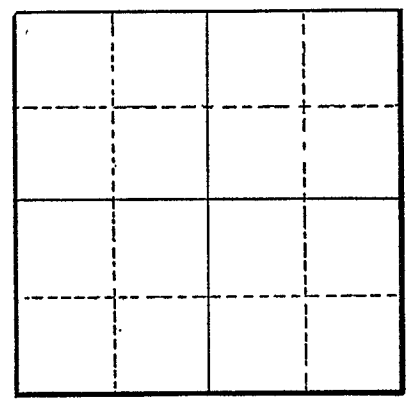

Section 1

Altitude at well \_\_\_\_\_

TYPE OF WELL: Drilled Date Constructed 1952

Depth drilled 227 Depth cased 197

### CASING RECORD:

8 inch

### FINISH:

### AQUIFERS:

### WATER LEVEL:

PUMPING EQUIPMENT: Type Peerless Turbine H.P. 15  
Capacity 150 G.P.M.

### WELL TESTS:

Drawdown \_\_\_\_\_ ft. after \_\_\_\_\_ hours Pumping 108 G.P.M.  
Drawdown \_\_\_\_\_ ft. after \_\_\_\_\_ hours G.P.M.

USE OF WATER Irrigation Temp. \_\_\_\_\_ °F., 19

SOURCE OF INFORMATION GR-2028

DRILLER or DIGGER R. Stadell, Silverton, Oregon

### ADDITIONAL DATA:

Log \_\_\_\_\_ Water Level Measurements \_\_\_\_\_ Chemical Analysis \_\_\_\_\_ Aquifer Test \_\_\_\_\_

### REMARKS: