

STATE ENGINEER
Salem, Oregon

3000
MARI.....

Well Record


STATE WELL NO. 6/1W-2Q(1)
COUNTY Marion
APPLICATION NO. GR-352

OWNER: Walter Duda
MAILING ADDRESS: Rt. 1, Box 16

LOCATION OF WELL: Owner's No. #1
CITY AND STATE: Mt. Angel, Oregon

SW 1/4 SE 1/4 Sec. 2 T. 6 N. S, R. 1 W., W.M.

Bearing and distance from section or subdivision
corner 712.6' N. & 1670.3' W. from S.E. Cor. of
Sec. 2

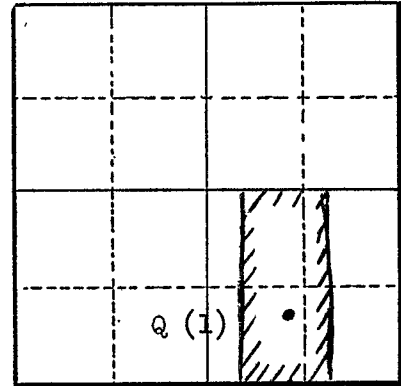

Section 2

Altitude at well 200

TYPE OF WELL: drilled Date Constructed 1948

Depth drilled 245 Depth cased 193

CASING RECORD:

8 inch

FINISH:

AQUIFERS:

WATER LEVEL:

5

PUMPING EQUIPMENT: Type turbine H.P. 7.5
Capacity 225 G.P.M.

WELL TESTS:

Drawdown ft. after hours G.P.M.
Drawdown ft. after hours G.P.M.

USE OF WATER Irrigation Temp. °F., 19

SOURCE OF INFORMATION Ground Water Registration Record

DRILLER or DIGGER Jim Ballweber, Woodburn, Oregon

ADDITIONAL DATA:

Log No. Water Level Measurements Chemical Analysis Aquifer Test

REMARKS: