
(1) OWNER. Nam. Rarroll & Fraemer Address 11 BOXEM Mt Angel Oreg. (2) TYPE OF WORK (check): New Well Despening Reconditioning Abandon It abandonment describe material and procedure in Henri 12 (3) TYPE OF WELL: (4) PROPOSED USE (check): Noisy S Driven Domestic Industrial Municipal Day Driven Day Driven	<u>3 aab</u> ~8 G-89		
Name Harold Traemer Address't Box64 Mt Angel, Oreg. (2) TYPE OF WORK (check): (3) TYPE OF WORK (check): (4) PROPOSED USE (check): (5) Despening Reconditioning Abandon Municipal Despening Reconditioning Despening Abandonment, describe material and procedure in Henr 12. (3) TYPE OF WELL: (4) PROPOSED USE (check): (5) Depth at which water was first found 35 Static level 30 st. below land surface. Dash 44 (5) CASING INSTALLED: Threaded Welded 1 12 Diam. from ft. to ft. Gage (7) Diam. from ft. to ft. Gage (8) PERFORATIONS: Perforated Type perforated Perforations from ft. to 340 st. perforations from ft. to 340 st. perforations from ft. to many perf			
Address Ht Box 84 Mt Angel Oreg (2) TYPE OF WORK (check): New Well			
New Well (
(3) TYPE OF WELL: (4) PROPOSED USE (check): Rotary & Driven Domestic Industrial Municipal Depth at which water was first found 35 Static lavel 30 ft. below land surface. Das6/4/ Artesian pressure Ibs. per square inch. Date CASING INSTALLED: Threaded Welded* 2	1000 W& 500 S of N.B. cor sec 3.T.6.S.R.1.W.		
CASING INSTALLED: Threaded Welded 1 12	71		
CASING INSTALLED: Threaded Welded E 12 "Diam. from 0 ft. to 340 ft. Gage			
to ft. Gage "Diam. Formation: Describe color, texture, grain size and structure of mand show thickness and nature of each stratum and aquifer pen with at least one entry for each change of formation. Report each of position of static Water Level and indicate principal water-bearing position of static Water Level and indicate principal water-bearing bostion PERFORATIONS: Perforated? 1 Yes No. Type of perforator used Factory preperferated Size of perforations 5/16 in. by 2½ in. 9000 + perforations from			
PERFORATIONS: Perforated			
Size of perforations 5/16 in. by 2½ in.			
Manufacturer's Name Model No. Type Model No. Diam. Slot size Set from ft. to ft. Diam. Slot size Set from ft. to ft. Inwered below static level Was a pump test made? X yes No if yes, by whom? Driller Yield: Baller test Artesian flow Perature of wate Well seal—Material us Well seal—Material us Well seal-Material us Well sealed from land s Diameter of well bore t Diameter of well bore t Number of sacks of ceme Med sand & gravel blue W.B. 35 448 Med conglomerate brn 48 60 Med sand & some small gravel 66 68 Olay blue sandy 68 76 78 87 Med sand grey W.B. 76 78 Clay grey 78 87 Med sand brn W.B. 87 90 Clay grey 78 87 Med sand brn W.B. 87 90 Clay prey 90 94 106 110 175 12y grey sandy 110 175 12y grey streaks of blk.sand175 182 W 1 12y grey streaks of blk.sand175 182 W 1 13y grey streaks of of certification: 13ing Machine Operator's Certification: 15ing Machine Operator's Certification:			
Type			
Type Model No. Diam. Slot size Set from ft. to ft. Diam. Slot size Set from ft. to ft. Diam. Slot size Set from ft. to ft. (8) WELL TESTS: Drawdown is amount water level is lowered below static level Was a pump test made? Nes No If yes, by whom?Driller Yield: Real-min with ft. 


Well seal—Material us Well sealed from land s Diameter of well bore t Diameter of well bore t Number of sacks of ceme Well sealed from land s Diameter of well bore t Number of sacks of ceme "ing Machine Operator's Certification: This well was constructed under my direct superverials used and information reported above are true nowledge and belief. Date 6/23/71, Wachine Operator's License No.			
Diameter of well bore to nowledge and belief. Diameter of well bore to dl. Date 6/23/71., Number of sacks of ceme. Number of sacks of ceme.	ision.		
Diameter of well bore t Optiming Machine Operator) Machine Operator's License No. 84	to my		
Number of sacks of ceme (Driking Machine Operator) Machine Operator's License No.	19		
[*] Machine Operator's License No. Of			
Number of sacks of benton	***********		
Brand name of bentonite . 'ell Contractor's Certification:			
Number of pounds of bentc			
of water true to the best of my knowledge and belief.	ort is		
Was a drive shoe used? \(\sume\) Ye \(\sum_{\text{Name}}\) Name \(\text{R. Stadeli& Sons}\)			
Did any strata contain unusa (Person, firm or corporation) (Type or print)	,		
Type of water? depth of strata Addressilverton, Oreg	AddresSilverton, Oreg		
Method of sealing strata off [Signed] Saul (7. Salli			
Method of sealing strata off Was well gravel packed? ▼ Yes □ No Size of gravel: ♣Pea [Signed] (Water Well Contractor)			
Gravel placed from35ft. t3/40ft	10		
(USE ADDITIONAL SHEETS IF NECESSARY)	19		

NOTICE TO WATER WELL STRAGOE VE The original and firs Popy of this report are to AUG 19 1971

AUG 19 1971

ATER WELL REPORT

STATE ENGINEER, SALEMSTRACTION OF OREGON (Please type or print) of well completion. (Do not write above this line)

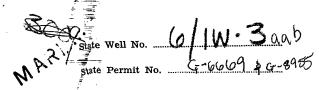

		· · · · · · · · · · · · · · · · · · ·	
(1) OWNER: Kraemer Cont.	(10) LOCATION OF WELL:		
Name	County Driller's well nu		
Address	1/4 Section T. R. W.M.		
(2) TYPE OF WORK (check):	Bearing and distance from section or subdivision corner		
New Well □ Deepening □ Reconditioning □ -Abandon □	S. N. Marie State State Company of State Company State Company		
If abandonment, describe material and procedure in Item 12.			
	(11) WATER LEVEL: Completed well.		
(3) TYPE OF WELL: (4) PROPOSED USE (check):	Depth at which water was first found	ft.	
Rotary Driven Domestic Industrial Municipal	Static level t, below land surface. Date		
Dug	Artesian pressure lbs. per square inch. Date		
CASING INSTALLED: Threaded Welded	(12) WELL LOG: Diameter of well below casing		
	Depth drilled ft. Depth of completed well ft.		
"Diam. from	Formation: Describe color texture, grain size and structure of materials;		
ft. Gage ft. Gage	and show thickness and nature of each stratum and aquifer penetrated, with at least one entry for each change of formation. Report each change in		
PERFORATIONS: Perforated? Yes No.	position of Static Water Level and indicate principal water-bearing strata.		
Type of perforator used	Glay sandy grey	182 195	
Size of perforations in. by in.	0	195 206	
	Max claystone grey.blue Clay brn.	206 228	
perforations from	""" Blue	228 235	
perforations from ft. to ft.	""" red gritty	235 266	
(7) SCREENS: Well screen_installed? Yes No	"""" brn.	266 281	
Manufacturer's Name	""" red	281 286	
Type Model No	mm brn.	286 325	
Diam Slot size Set from ft. to ft.	Soft decomposed basalt brn	325 331	
Diam, Slot size Set from ft. to ft.	"""" grey	331 335	
(8) WELL TESTS: Drawdown is amount water level is	Med basalt blk.	335 340	
iowered below static lever	H. basalt grey	340 360	
Was a pump test made? ☐ Yes ☐ No If yes, by whom?	Med basalt pouros blk.W.B. H. basalt grey	360 390	
Yield: gal./min. with ft. drawdown after hrs.	ne basart grey	390 395	
" " "	The second secon		
" " "			
Bailer test gal./min. with ft. drawdown after hrs.			
Artesian flow g.p.m.			
nperature of water Depth artesian flow encountered ft.	Work started 19 Completed 19		
(9) CONSTRUCTION:	Date well drilling machine moved off of well 19		
Well seal—Material used	Drilling Machine Operator's Certification:		
Well sealed from land surface to ft.	This well was constructed under my direct supervision.		
Diameter of well bore to bottom of seal in.	best knowledge and belief.		
Diameter of well bore below seal in.	[Signed] Date, 19		
Number of sacks of cement used in well seal sacks	Drilling Machine Operator's License No.		
Number of sacks of bentonite used in well seal sacks	S		
Brand name of bentonite	Water Well Contractor's Certification:		
Number of pounds of bentonite per 100 gallons of water lbs./100 gals.	This well was drilled under my jurisdiction and this report is true to the best of my knowledge and belief.		
Was a drive shoe used? $\hfill \square$ Yes $\hfill \square$ No \hfill Plugs Size: location ft.			
Did any strata contain unusable water? Yes No	Name (Person, firm or corporation) (Type or print)		
Type of water? depth of strata	Address -		
thod of sealing strata off [Signed]			
Was well gravel packed? ☐ Yes ☐ No Size of gravel:	[Signed] (Water Well Contractor)		
Gravel placed from ft. to ft.	Contractor's License No Date	, 19	