

STATE ENGINEER
Salem, Oregon

3014
MAR 1947

Well Record

STATE WELL NO. 6/1W-3M (1)
COUNTY Marion
APPLICATION NO. GR-421

OWNER: John J. Schmitz

MAILING ADDRESS:

LOCATION OF WELL: Owner's No.


CITY AND STATE:

Mt. Angel, Oregon

NW 1/4 SW 1/4 Sec. 3 T. 6 N. S, R. 1 W., W.M.

Bearing and distance from section or subdivision

corner 2630 feet N. 10° 30' E. of SW Cor. Sec. 3

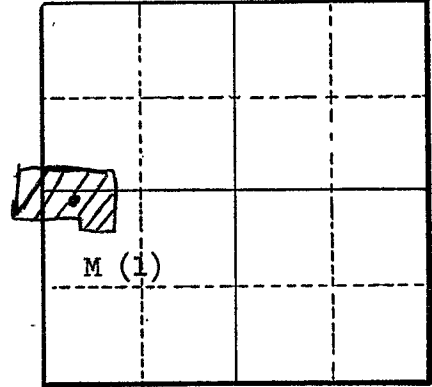

Section 3

Altitude at well 185

TYPE OF WELL drilled Date Constructed July 1947

Depth drilled 204 Depth cased

CASING RECORD:

8 inch to 80 feet

6 inch 80 to 204 feet

FINISH:

AQUIFERS:

WATER LEVEL:

16

PUMPING EQUIPMENT: Type Peerless Turbine H.P. 7 1/2
Capacity 60 G.P.M.

WELL TESTS:

Drawdown ft. after hours G.P.M.

Drawdown ft. after hours G.P.M.

USE OF WATER Irrigation 34.5 Acre Temp. °F., 19

SOURCE OF INFORMATION GR-421

DRILLER or DIGGER James Ballweber; Woodburn, Oregon

ADDITIONAL DATA:

Log No. Water Level Measurements Chemical Analysis Aquifer Test

REMARKS: