

STATE ENGINEER  
Salem, Oregon



# Well Record


STATE WELL NO. 6/1W-4A(1)  
COUNTY Marion  
APPLICATION NO. GR-931

OWNER: Frank J. Each MAILING ADDRESS: \_\_\_\_\_

LOCATION OF WELL: Owner's No. \_\_\_\_\_ CITY AND STATE: Mt. Angel, Oregon

NE 1/4 NE 1/4 Sec. 4 T. 6 S. R. 1 W., W.M.

Bearing and distance from section or subdivision  
corner 400' W. & 85' S. from NE Cor. Sec. 4

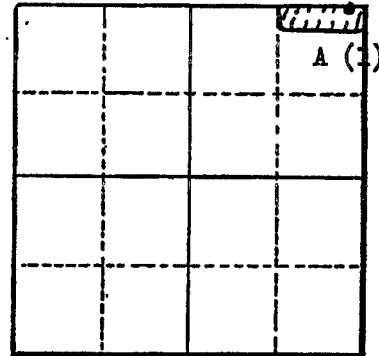

Altitude at well 195

TYPE OF WELL: \_\_\_\_\_ Date Constructed August 1937

Depth drilled 163 Depth cased 115

Section 4

### CASING RECORD:

5' 0'-115

### FINISH:

Open End Casing

### AQUIFERS:

Gravel-95'-100GPM

### WATER LEVEL:

20'

PUMPING EQUIPMENT: Type Turbine H.P. 3  
Capacity 100 G.P.M.

### WELL TESTS:

Drawdown \_\_\_\_\_ ft. after \_\_\_\_\_ hours \_\_\_\_\_ G.P.M.  
Drawdown \_\_\_\_\_ ft. after \_\_\_\_\_ hours \_\_\_\_\_ G.P.M.

USE OF WATER Irrigation Temp. \_\_\_\_\_ °F. \_\_\_\_\_, 19\_\_\_\_

SOURCE OF INFORMATION Owner

DRILLER or DIGGER \_\_\_\_\_

### ADDITIONAL DATA:

Log X Water Level Measurements \_\_\_\_\_ Chemical Analysis \_\_\_\_\_ Aquifer Test \_\_\_\_\_

### REMARKS:

