

STATE ENGINEER
Salem, Oregon

303/
MARI....

Well Record

STATE WELL NO. 6/1W-4B
COUNTY Marion
APPLICATION NO. GR-1706

GR- 1655

OWNER: Fred J. Schwab

MAILING
ADDRESS:


LOCATION OF WELL: Owner's No. #1

CITY AND
STATE:

Mt. Angel, Oregon

NW 1/4 NE 1/4 Sec. 4 T. 6 S., R. 1 W., W.M.

Bearing and distance from section or subdivision
corner 4100' N.102°15'E. from NW cor. Sec. 4

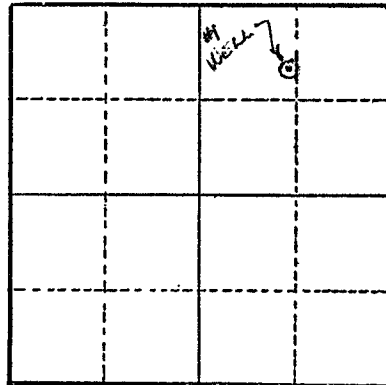

Section 4

Altitude at well 200'

TYPE OF WELL: Drilled Date Constructed 1946

Depth drilled 111' Depth cased 111'

CASING RECORD:

6"

FINISH:

AQUIFERS:

WATER LEVEL:

27'

PUMPING EQUIPMENT: Type 4" turbine H.P. 10
Capacity 170 G.P.M.

WELL TESTS:

Drawdown 85 ft. after hours 170 G.P.M.

Drawdown ft. after hours G.P.M.

USE OF WATER Irrigation Temp. °F., 19

SOURCE OF INFORMATION GR Record

DRILLER or DIGGER James Ballweber

ADDITIONAL DATA:

Log N.A. Water Level Measurements Chemical Analysis Aquifer Test

REMARKS:

Irrigation of 100 acres.