

STATE ENGINEER
Salem, Oregon

3033
MARI.....


Well Record

STATE WELL NO. 6/1W-4 D(1)
COUNTY Marion
APPLICATION NO. GR-550

OWNER: W. J. Kloft
MAILING ADDRESS:

LOCATION OF WELL: Owner's No. CITY AND STATE: Mt. Angel, Oregon

NW 1/4 NW 1/4 Sec. 4 T. 6 N. S., R. 1 W., W.M.
Bearing and distance from section or subdivision
corner 6.54 ch. S. & 20 feet E. of NW Cor.
Sec. 4

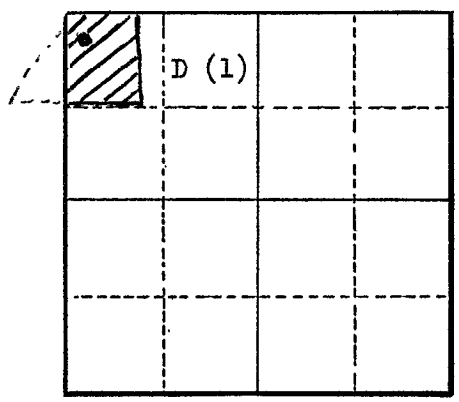

Altitude at well 145

TYPE OF WELL: Drilled Date Constructed 1940
Depth drilled 73 Depth cased 73

CASING RECORD:
8 inch

FINISH:

AQUIFERS:

WATER LEVEL:
2 Feet

PUMPING EQUIPMENT: Type Jacuzzi Turbine H.P. 5
Capacity 150 G.P.M.

WELL TESTS:
Drawdown ft. after hours G.P.M.
Drawdown ft. after hours G.P.M.

USE OF WATER Irrigation 33 Acres Temp. °F. 19

SOURCE OF INFORMATION GR-550
DRILLER or DIGGER Jim Balweber

ADDITIONAL DATA:
Log Water Level Measurements Chemical Analysis Aquifer Test

REMARKS: