

STATE ENGINEER
Salem, Oregon

3038
MARI.....

Well Record

STATE WELL NO. 6/1W-4J
COUNTY Marion
APPLICATION NO. GR-3878

OWNER: Geo. P. Bielemeier


MAILING ADDRESS: Mr. Angel Route 1, Box 180

LOCATION OF WELL: Owner's No. _____

CITY AND STATE: Oregon

NE 1/4 SE 1/4 Sec. 4 T. 6 S., R. 1 W., W.M.

Bearing and distance from section or subdivision corner 1460 feet North and 410 feet West from the SE Corner, Section 4

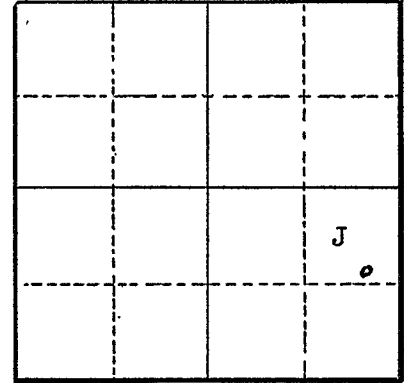

Section 4

Altitude at well _____

TYPE OF WELL: Drilled Date Constructed 1948

Depth drilled 175 feet Depth cased _____

CASING RECORD:

6-inch casing (steel) set from 0 to _____ feet

FINISH:

AQUIFERS:

WATER LEVEL:

40 feet

PUMPING EQUIPMENT: Type Jet H.P. _____
Capacity 20 G.P.M.

WELL TESTS:

Drawdown 150 ft. after _____ hours 66 G.P.M.

Drawdown _____ ft. after _____ hours _____ G.P.M.

USE OF WATER Irrigation Temp. _____ °F., 19 _____

SOURCE OF INFORMATION GR-4060

DRILLER or DIGGER _____

ADDITIONAL DATA:

Log (NA) Water Level Measurements _____ Chemical Analysis _____ Aquifer Test _____

REMARKS: