

STATE ENGINEER
Salem, Oregon

3050
MARION

Well Record

STATE WELL NO. 6/1W-6E(1)
COUNTY Marion
APPLICATION NO. GR-1047

GR- 1009

OWNER: Peter J. Miller


MAILING ADDRESS: Box 133

LOCATION OF WELL: Owner's No. #1

CITY AND STATE: Brooks, Oregon

SW 1/4 NW 1/4 Sec. 6 T. 6 S. R. 1 W., W.M.

Bearing and distance from section or subdivision corner 500' N & 154' E. from W 1/4 cor. of Sec. 6.

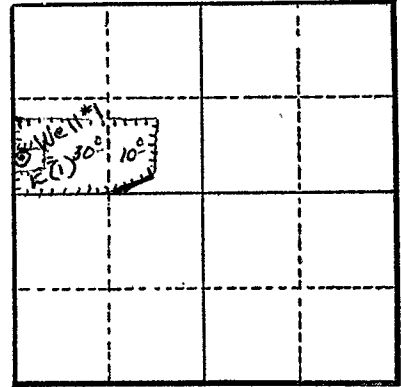

Section 6

Altitude at well 160 ft.

TYPE OF WELL: Drilled Date Constructed 1942

Depth drilled 107 ft. Depth cased 107 ft.

CASING RECORD:

6 inch

FINISH:

AQUIFERS:

WATER LEVEL:

16 ft.

PUMPING EQUIPMENT: Type Jet H.P. 5

Capacity 120 G.P.M.

WELL TESTS:

Drawdown 40 ft. after 120 hours G.P.M.

Drawdown ft. after hours G.P.M.

USE OF WATER Irrigation Temp. °F. 19

SOURCE OF INFORMATION G.R. Record

DRILLER or DIGGER Ballweber

ADDITIONAL DATA:

Log N.A. Water Level Measurements Chemical Analysis Aquifer Test

REMARKS:

Irrigation of 40 acres.