

STATE ENGINEER  
Salem, Oregon

3055  
MARION

# Well Record

STATE WELL NO. 6/1W-6P  
COUNTY Marion  
APPLICATION NO. GR-1634

GR- 1599

OWNER: Alfred Dettwyler


MAILING ADDRESS: Rt. 2, Box 281

LOCATION OF WELL: Owner's No.

CITY AND STATE: Silverton, Oregon

SE 1/4 SW 1/4 Sec. 6 T. 6 S., R. 1 W., W.M.

Bearing and distance from section or subdivision corner 720' W. & 660' N. from S<sup>1</sup>/<sub>4</sub> cor. Sec. 6

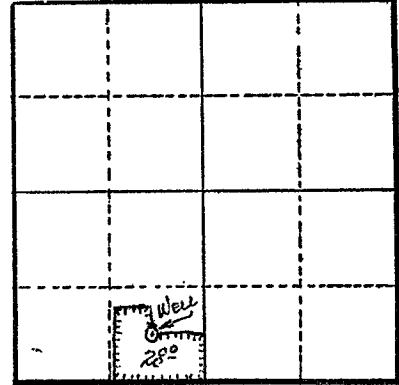

Section 6

Altitude at well 150'

TYPE OF WELL: Drilled Date Constructed 1950

Depth drilled 119' Depth cased 119'

CASING RECORD:  
10"

FINISH:

AQUIFERS:

WATER LEVEL:  
40'

PUMPING EQUIPMENT: Type Berkeley turbine H.P. 15  
Capacity 180 G.P.M.

WELL TESTS:  
Drawdown 45 ft. after 275 hours G.P.M.  
Drawdown ft. after hours G.P.M.

USE OF WATER Irrigation Temp. °F., 19

SOURCE OF INFORMATION GR Record

DRILLER or DIGGER Rudolph Stadeli

ADDITIONAL DATA:

Log N.A. Water Level Measurements Chemical Analysis Aquifer Test

REMARKS:

Irrigation of 28 acres.