

STATE ENGINEER
Salem, Oregon

3060
MARI.....

Well Record


STATE WELL NO. 6/1W-7B (1)
COUNTY Marion
APPLICATION NO. GR-212

OWNER: David Gerig
MAILING ADDRESS: Rt. 1, Box 92

LOCATION OF WELL: Owner's No. #1
CITY AND STATE: Brooks, Oregon

NW 1/4 NE 1/4 Sec. 7 T. 6 S., R. 1 W., W.M.

Bearing and distance from section or subdivision
corner N. 20° 57' W. 21.52 chains from the most
South Southwest corner of W. Parker D.L.C.

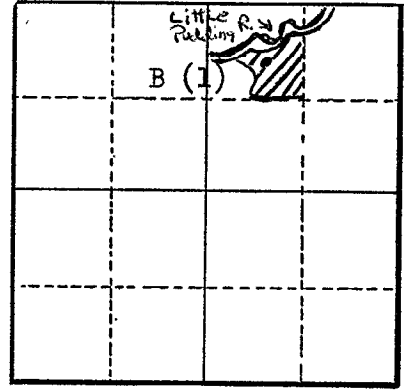

Section 7

Altitude at well 150' Interpolated

TYPE OF WELL: Drilled Date Constructed Sept. 1949

Depth drilled 113 Depth cased 113

CASING RECORD:

8 inch steel casing set from 0 to 113 feet.

FINISH:

Unknown

AQUIFERS:

Unknown

WATER LEVEL:

50 feet below land surface

PUMPING EQUIPMENT: Type Jet Capacity 60 G.P.M. H.P. 5

WELL TESTS:

Drawdown ft. after hours G.P.M.
Drawdown ft. after hours G.P.M.

USE OF WATER Irrigation 10 acres Temp. °F. 19

SOURCE OF INFORMATION Registration Statement GR-212

DRILLER or DIGGER J. A. Sneed & Sons

ADDITIONAL DATA:

Log No. Water Level Measurements Chemical Analysis Aquifer Test

REMARKS: